

PIKE
K49
5-27-71

MISSISSIPPI
BOARD OF WATER COMMISSIONERS
416 North State Street
Jackson, Mississippi 39201

CODED

WATER WELL DRILLERS-LOG

5-27 1971 Fitzgerald Well Serv Pike
date well completed firm name county well located

LANDOWNER:
Raul Ott

P.R. Stephens
(mailing address)

WELL LOCATION:
sec. 23T 1N 5S R. 7E W

1 miles N of Stephens
(distance) (direction) (nearest town)

WELL PURPOSE: Home
(home, irrigation, municipal, industrial)

description of formations encountered	from	to
<u>Red Clay</u>	<u>0</u>	<u>20</u>
<u>Red sand</u>	<u>20</u>	<u>80</u>
<u>Fine sand</u>	<u>80</u>	<u>150</u>
<u>Coarse sand</u>	<u>150</u>	<u>167</u>

WELL COMPLETION DATA:

(1) diameter (inches) 4

(2) total depth (feet) 167

(3) static water level (feet) 20 below top of ground.

(4) casing Alastic 152
(material) (depth)
4 (size) if telescope see back.

(5) screen 15 152
(length) (depth to top)
4 (size) Alastic (material)

(6) pump 3/4 75
(HP) (yield gpm)
elec (type power)

(7) electric log no
(yes or no)
(organization running log)

(8) how well bottom plugged no seal pan

CODED


JUN 14 1971

DRILLERS REMARKS:

MISS. BD. OF
WATER COMM.

If well telescopes please sketch and show depths.

GROUND LEVEL

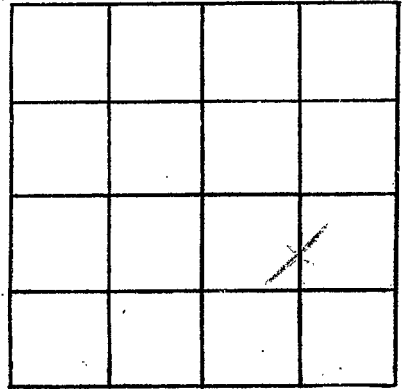

SECTION _____

Please indicate well location X.

ADDITIONAL INFORMATION

If more than one screen,
show locations of each on sketch.