

Pike
 K-50
 7-9-71

MISSISSIPPI
 BOARD OF WATER COMMISSIONERS
 416 North State Street
 Jackson, Mississippi 39201

CODED

WATER WELL DRILLERS LOG

7-9 1971 Flourish Well Co Pike
 date well completed firm name county well located

LANDOWNER:	description of formations encountered	from	to
<u>A. Hanes</u>	<u>Red Clay</u>	<u>0</u>	<u>20</u>
<u>F.B. Magnolia</u> (mailing address)	<u>White Clay</u>	<u>20</u>	<u>40</u>
	<u>Blue Clay</u>	<u>40</u>	<u>140</u>
	<u>Coarse Sand</u>	<u>140</u>	<u>156</u>
WELL LOCATION:			
sec. <u>3</u> T. <u>1</u> N. R. <u>7</u> E			
<u>5</u> miles <u>S</u> of <u>Magnolia</u> (distance) (direction) (nearest town)			
WELL PURPOSE: <u>Home</u> (home, irrigation, municipal, industrial)			
WELL COMPLETION DATA:			
(1) diameter (inches) <u>4</u>			
(2) total depth (feet) <u>154</u>			
(3) static water level (feet) <u>80</u> below above top of ground.			
(4) casing <u>Plastic</u> <u>146</u> (material) (depth) <u>4</u> (size) if telescope see back.			
(5) screen <u>8</u> <u>146</u> (length) (depth to top)			
(6) pump <u>4</u> <u>Plastic</u> (size) (material)			
(6) pump <u>1/2</u> <u>10</u> (HP) (yield gpm)			
<u>Electric</u> (type power)			
(7) electric log <u>No</u> (yes or no)			
(organization running log)			
(8) how well bottom plugged <u>Wood</u>			
DRILLERS REMARKS:			


CODED

AUG 11 1971

MISS. BD. OF
 WATER COMMISSIONERS

If well telescopes please sketch and show depths.

GROUND LEVEL

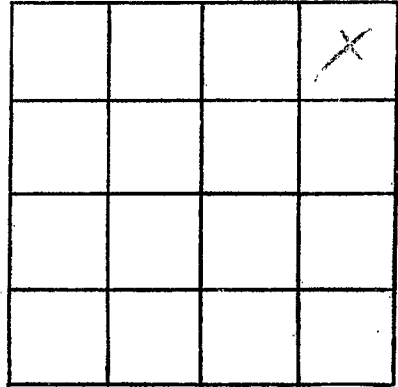

SECTION 3

Please indicate well location X.

ADDITIONAL INFORMATION

If more than one screen,
show locations of each on sketch.