

Pike
K-51
8-12-71

MISSISSIPPI
BOARD OF WATER COMMISSIONERS
416 North State Street
Jackson, Mississippi 39201

WATER WELL DRILLERS LOG

CODED

8-12-71 date well completed 1971 F. L. Dickey well name county well located

LANDOWNER:	description of formations encountered	from	to
L. L. Dickey			
RR Oayka miss (mailing address)	Red Clay Red gravel Cannon ball & gravel	0 20 92	20 92 117
WELL LOCATION:			
sec. 29 T-1 N R-7 E			
4 miles W of Oayka (distance) (direction) (nearest town)			
WELL PURPOSE: Home (home, irrigation, municipal, industrial)			
WELL COMPLETION DATA:			
(1) diameter (inches) 4			
(2) total depth (feet) 117			
(3) static water level (feet) 80 below top of ground.			
(4) casing plastic, 109 (material) (depth)			
4 (size) if telescope see back.			
(5) screen 8 (length), 109 (depth to top)			
4 (size), plastic (material)			
(6) pump 1 (HP), 6 (yield gpm)			
Ela (type power)			
(7) electric log No (yes or no)			
(organization running log)			
(8) how well bottom plugged w/ gravel			
DRILLERS REMARKS:			


CODED

SEP 15 1971

MISSISSIPPI
BOARD OF WATER COMMISSIONERS
416 NORTH STATE STREET
JACKSON, MISSISSIPPI 39201

If well telescopes please sketch and show depths.

GROUND LEVEL

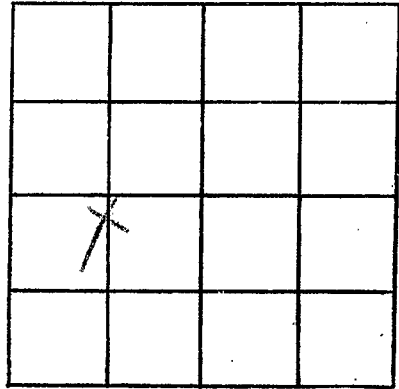

SECTION 29

Please indicate well location X.

ADDITIONAL INFORMATION

If more than one screen,
show locations of each on sketch.