

Pike  
K-52  
8-25-71

MISSISSIPPI  
BOARD OF WATER COMMISSIONERS  
416 North State Street  
Jackson, Mississippi 39201

WATER WELL DRILLERS LOG

**CODED**  
Mississippi

8-25  
date well completed

1971 *Flourish Well Co*  
firm name

county well located

LANDOWNER:  
*Scott Farr*  
*P.R. Magnolia miss.*  
(milling address)

description of formations encountered	from	to
<i>Red Clay</i>	<i>6</i>	<i>20</i>
<i>Red gravel</i>	<i>20</i>	<i>90</i>
<i>Loose sand &amp; gravel</i>	<i>90</i>	<i>98</i>

WELL LOCATION:  
sec. *11* T. *1* N. R. *2* E  
*5* miles *S* of *Magnolia*  
(distance) (direction) (nearest town)

WELL PURPOSE: *Home*  
(home, irrigation, municipal, industrial)

- WELL COMPLETION DATA:
- (1) diameter (inches) *3 1/4*
  - (2) total depth (feet) *98*
  - (3) static water level (feet) *55* below top of ground.
  - (4) casing *Plastic, 90*  
(material) (depth)  
*4* if telescope see back.  
(size)
  - (5) screen *8, 90*  
(length) (depth to top)  
*4* (size), *Plastic* (material)
  - (6) pump *1/2, 9*  
(HP) (yield gpm)  
*elec* (type power)
  - (7) electric log *no*  
(yes or no)  
(organization running log)
  - (8) how well bottom plugged *as well as possible*

**CODED**


SEP 15 1971

DRILLERS REMARKS:

MISS. BD. OF  
WATER COMM.

If well telescopes please sketch and show depths.

GROUND LEVEL

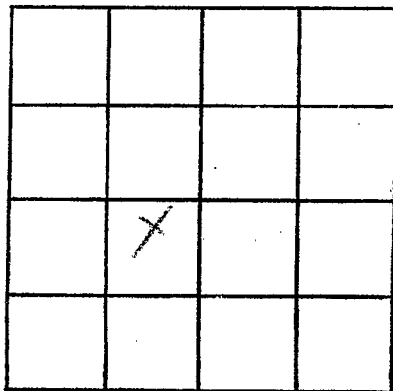

SECTION 11

Please indicate well location X.

ADDITIONAL INFORMATION

If more than one screen,  
show locations of each on sketch.