

MISSISSIPPI  
BOARD OF WATER COMMISSIONERS  
416 North State Street  
Jackson, Mississippi 39201

WATER WELL DRILLERS LOG

**CODED**  
K-54

Pike  
K-54  
6-19-71

June 19, 1971 Chelikerne  
date well completed firm name county well located

LANDOWNER: Mrs. Baltus  
Carter -  
Rt 2, Osyka  
(mailing address)

description of formations encountered	from	to
Clay	0	20
Red Sand	20	74
Sand & gravel	74	86
Sandy gravel & clay	86	145
Coarse sand & gravel	145	158

WELL LOCATION:  
sec 20 T 1 N R 7 E  
3 miles W.W. of Osyka  
(distance) (direction) (nearest town)

WELL PURPOSE: Farm  
(home, irrigation, municipal, industrial)

- WELL COMPLETION DATA:
- (1) diameter (inches) 16"
  - (2) total depth (feet) 158
  - (3) static water level (feet) 74 below top of ground
  - (4) casing (material) Plast Baltus (depth)
  - (5) screen (length) 6' (depth to top) 152'
  - (6) pump (HP) 1/2 (yield gpm) 12
  - (7) electric log (yes or no) No
  - (8) how well bottom plugged wooden plug

**CODED**


SEP 17 1971

MISS. BD. OF WATER COMM.

DRILLERS REMARKS: old well bad

If well telescopes please sketch and show depths.

GROUND LEVEL

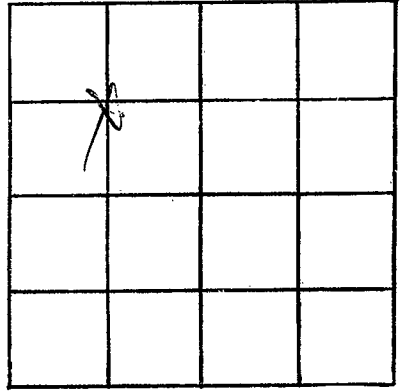

SECTION 20

Please indicate well location X.

ADDITIONAL INFORMATION

If more than one screen,  
show locations of each on sketch.