

Pike
K 55
9-15-71

MISSISSIPPI
BOARD OF WATER COMMISSIONERS
416 North State Street
Jackson, Mississippi 39201

WATER WELL DRILLERS LOG

CODED

9-15

date well completed

19

21 *Fitzgerald Well Co*

firm name

Pike
county well located

LANDOWNER:
Edmund J. Johnson
R.R. Dwyer mess.
(mailing address)

description of formations encountered	from	to
<i>Red Clay</i>	<i>0</i>	<i>20</i>
<i>Red Chalk</i>	<i>20</i>	<i>60</i>
<i>Red Sand</i>	<i>60</i>	<i>75</i>
<i>Coarse-beds gravel</i>	<i>75</i>	<i>108</i>

WELL LOCATION:
sec. 17 T-1 N S R-7 E W
5 miles W of Osprey
(distance) (direction) (nearest town)

WELL PURPOSE:
Home
(home, irrigation, municipal, industrial)

- WELL COMPLETION DATA:
- (1) diameter (inches) 4
 - (2) total depth (feet) 108
 - (3) static water level (feet) 70 below above top of ground.
 - (4) casing Plastic, 100,
(material) (depth)
4 if telescope see back.
(size)
 - (5) screen 8, no
(length) (depth to top)
4, Plastic
(size) (material)
 - (6) pump 1/2, 10
(HP) (yield gpm)
60
(type power)
 - (7) electric log no
(yes or no)
(organization running log)
 - (8) how well bottom plugged wood peg

CODED


OCT 28 1971

MISS. Bd. OF
WATER COM.

DRILLERS REMARKS:

If well telescopes please sketch and show depths.

GROUND LEVEL

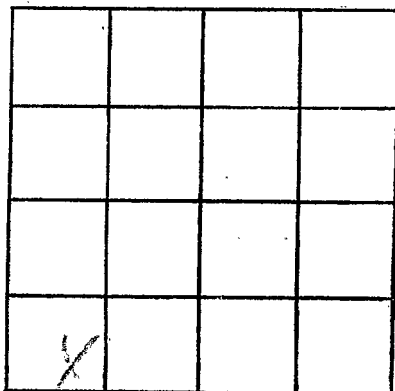

SECTION 107

Please indicate well location X.

ADDITIONAL INFORMATION

If more than one screen,
show locations of each on sketch.