

Pike
K 56
11-16-71

MISSISSIPPI
BOARD OF WATER COMMISSIONERS
416 North State Street
Jackson, Mississippi 39201

NOV 28 1971
CODED
WATER DIVISION

WATER WELL DRILLERS LOG


11-16 date well completed 19 71 firm name *Fitzgerald Well Serv* county well located *Pike*

LANDOWNER:	description of formations encountered	from	to
<i>Alton Robert</i>			
<i>RR. Ouyka Miss.</i> (mailing address)	<i>Red sand</i>	0	20
WELL LOCATION:	<i>Red gravel</i>	20	120
sec. <i>21</i> T. <i>1</i> N. R. <i>7</i> E	<i>Red sand</i>	120	235
<i>4</i> miles <i>W</i> of <i>Ouyka</i>	<i>Coarse sand</i>	235	261
(distance) (direction) (nearest town)			
WELL PURPOSE: <i>Home</i> (home, irrigation, municipal, industrial)			
WELL COMPLETION DATA:			
(1) diameter (inches) <i>4</i>			
(2) total depth (feet) <i>261</i>			
(3) static water level (feet) <i>100</i> below top of ground.			
(4) casing <i>Plastic</i> <i>247</i> (material) (depth)			
<i>4</i> if telescope see back. (size)			
(5) screen <i>14</i> <i>247</i> (length) (depth to top)			
<i>4</i> <i>plastic</i> (size) (material)			
(6) pump <i>1 1/2</i> <i>35</i> (HP) (yield gpm)			
<i>cl</i> (type power)			
(7) electric log <i>no</i> (yes or no)			
(organization running log)			
(8) how well bottom plugged <i>Wood peg</i>			
DRILLERS REMARKS:			

CODED

If well telescopes please sketch and show depths.

GROUND LEVEL

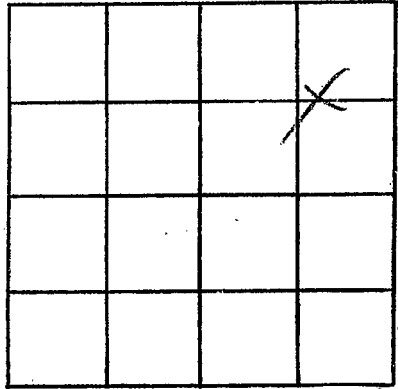

SECTION 21

Please indicate well location X.

ADDITIONAL INFORMATION

If more than one screen,
show locations of each on sketch.