

Pike
K 57
11-17-71

MISSISSIPPI
BOARD OF WATER COMMISSIONERS
416 North State Street
Jackson, Mississippi 39201

CODED

WATER WELL DRILLERS LOG

NOV 17 1971 *Charters Keens* *Pike*
date well completed firm name county well located

LANDOWNER: *Jack*
Elston
H. W. Osyka
(mailing address)

| description of formations encountered | from | to |
|---------------------------------------|------------|------------|
| <i>Red clay</i> | <i>0</i> | <i>22</i> |
| <i>Red sand</i> | <i>22</i> | <i>56</i> |
| <i>Sand & gravel</i> | <i>56</i> | <i>80</i> |
| <i>Red silty sand</i> | <i>80</i> | <i>117</i> |
| <i>Red gravel sand</i> | <i>117</i> | <i>126</i> |

WELL LOCATION:
sec. *22* T. *1* N. R. *7* E
2 miles *NE* of *Osyka*
(distance) (direction) (nearest town)

WELL PURPOSE: *Home*
(home, irrigation, municipal, industrial)

- WELL COMPLETION DATA:
- (1) diameter (inches) *6"*
 - (2) total depth (feet) *120*
 - (3) static water level (feet) _____ below/above top of ground.
 - (4) casing *Plast Ballou*
(material) (depth)
 - (size) if telescope see back.
 - (5) screen *6'* *120'*
(length) (depth to top)
 - 4"* *Plast*
(size) (material)
 - (6) pump *1/2 Sub 12*
(HP) (yield gpm)
 - Elect*
(type power)
 - (7) electric log *NO*
(yes or no)
 - (organization running log)


CODED

(8) how well bottom plugged
W/accum plug

DRILLERS REMARKS:
New house

If well telescopes please sketch and show depths.

GROUND LEVEL

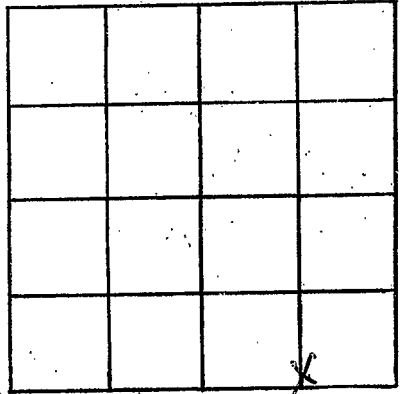

SECTION 22

Please indicate well location X.

ADDITIONAL INFORMATION

If more than one screen, show locations of each on sketch.