

PIKE
K 58
3-15-72

CODED MISSISSIPPI
BOARD OF WATER COMMISSIONERS
416 North State Street
Jackson, Mississippi 39201

MAR 21 1972

WATER WELL DRILLERS LOG

3-15 19 72 Fitzgerald Well Service Cole
date well completed firm name county well located

LANDOWNER:
Ref Ott
B.R. O'Connell
(mailing address)

WELL LOCATION:
sec. 27 T 1 N R 7 E
S W
2 miles W of Oxya
(distance) (direction) (nearest town)

WELL PURPOSE: Home
(home, irrigation, municipal, industrial)

- WELL COMPLETION DATA:
- (1) diameter (inches) 4
 - (2) total depth (feet) 123
 - (3) static water level (feet) 85 Below top of ground.
 - (4) casing Plastic, 115,
(material) (depth)
4 if telescope see back.
(size)
 - (5) screen 8, 115
(length) (depth to top)
4, Plastic
(size) (material)
 - (6) pump 1/2, 10
(HP) (yield gpm)
ele
(type power)
 - (7) electric log no
(yes or no)
(organization running log)
 - (8) how well bottom plugged covered


description of formations encountered	from	to
<u>Red clay</u>	<u>0</u>	<u>20</u>
<u>Red sand</u>	<u>20</u>	<u>80</u>
<u>Red clay</u>	<u>80</u>	<u>110</u>
<u>Coarse sand & gravel</u>	<u>110</u>	<u>123</u>

CODED

DRILLERS REMARKS:

If well telescopes please sketch and show depths.

GROUND LEVEL

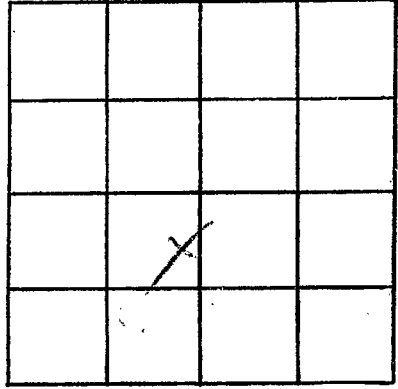

SECTION 27

Please indicate well location X.

ADDITIONAL INFORMATION

If more than one screen,
show locations of each on sketch.