

MISSISSIPPI  
 BOARD OF WATER COMMISSIONERS  
 416 North State Street  
 Jackson, Mississippi 39201

**CODED**

WATER WELL DRILLERS LOG

Pike  
 K 59  
 4-24-72

date well completed April 24 1972 firm name Chester Keene county well located Pike

LANDOWNER: Mary Hayes  
R. Z. Oayha

description of formations encountered	from	to
Red Sandy clay	0	12
Red sand shale	12	60
Sand & gravel	60	76
chalk mixed with gravel	76	98
small gravel and coarse sand	98	117

(mailing address)

WELL LOCATION:  
 sec. 17 T. 1 N. R. 7 E  
4 miles NW of Oayha  
 (distance) (direction) (nearest town)

WELL PURPOSE: Home  
 (home, irrigation, municipal, industrial)

WELL COMPLETION DATA:

- (1) diameter (inches) 4"
- (2) total depth (feet) 117
- (3) static water level (feet) 60 below top of ground
- (4) casing Plast. galv.  
 (material) (depth)
- 6' If telescope see back.  
 (size)
- (5) screen 6' 11'  
 (length) (depth to top)  
4" Plast.  
 (size) (material)
- (6) pump 1/2 HP 12  
 (HP) (yield gpm)  
elec  
 (type power)
- (7) electric log no  
 (yes or no)

**CODED**

(organization running log)

(8) how well bottom plugged  
wood plug


DRILLERS REMARKS:  
new house.

JUN 30 1972

MISS. DEP. OF  
 WATER COMMISSIONERS

If well telescopes please sketch and show depths.

GROUND LEVEL

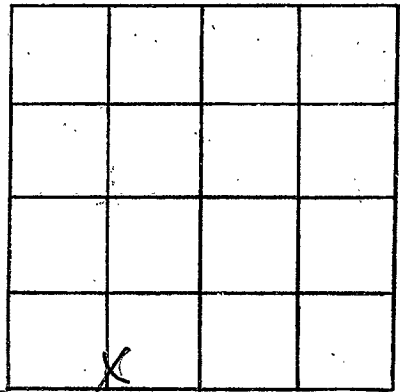

SECTION 17

Please indicate well location X.

ADDITIONAL INFORMATION

Lined area for additional information.

If more than one screen, show locations of each on sketch.