

Pike
K 60
6-9-72

MISSISSIPPI
BOARD OF WATER COMMISSIONERS
416 North State Street
Jackson, Mississippi 39201

CODED

WATER WELL DRILLERS LOG

June 9 1972 date well completed
H. VARNADO SONS INC. firm name
PIKE county well located

LANDOWNER: E. J. ERVIN
MAGNOLIA, MISS.
CHATHWA
(mailing address)

WELL LOCATION:
sec. 15 T 1 N R 7 E
10.5 miles S of McComb
(distance) (direction) (nearest town)

WELL PURPOSE: HOME
(home, irrigation, municipal, industrial)

WELL COMPLETION DATA:

(1) diameter (inches) 4" Plastic
(2) total depth (feet) 158'
(3) static water level (feet) 68 below above top of ground.
(4) casing 4" Plastic (material) (depth)
 (size) if telescope see back.
(5) screen 10' (length) (depth to top)
 4" Plastic (size) (material)
(6) pump 1/2 HP 900 (HP) (yield gpm) H
 ELECT. (type power)
(7) electric log NO Cone (yes or no)
 (organization running log)
(8) how well bottom plugged GAPPED

description of formations encountered	from	to
Clay	0	15
SAND + GRAVEL	15	65
Clay off color white	65	70
PEARL GRAVEL + SAND	70	80
IRON ROCK	80	84
LARGE GRAVEL	84	90
GRAVEL + SAND	90	94
Clay	94	122
SAND + PEARL GRAVEL	122	130
LARGE SAND	130	158


CODED

JUL 17 1972

DRILLERS REMARKS: PURE
HELL

If well telescopes please sketch and show depths.

GROUND LEVEL

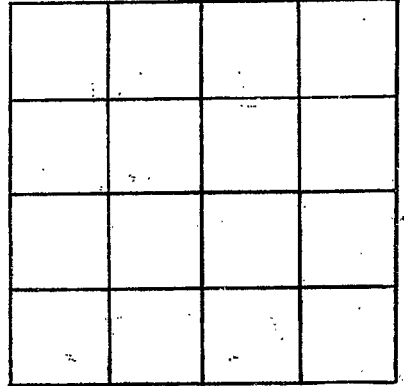

SECTION _____

Please indicate well location X.

ADDITIONAL INFORMATION

*The worst drilling
I have ever drilled
in Miss.*

If more than one screen,
show locations of each on sketch.