

Pike  
K 61  
9-28-72

MISSISSIPPI  
BOARD OF WATER COMMISSIONERS  
416 North State Street  
Jackson, Mississippi 39201

WATER WELL DRILLERS LOG

**CODED**

9-28 1972 Fitzgerald Pelle  
date well completed firm name county well located

LANDOWNER:

M. L. Ritter

R.R. Maxnolin Min  
(mailing address)

WELL LOCATION:

sec. 1 T. 1 N. R. 7 E

5 miles S of Masnolin  
(distance) (direction) (nearest town)

WELL PURPOSE:

Home  
(home, irrigation, municipal, industrial)

WELL COMPLETION DATA:

(1) diameter (inches) 4  
(2) total depth (feet) 130  
(3) static water level (feet) 100 below above top of ground.

(4) casing plastic 122  
(material) (depth)  
4 if telescope see back.  
(size)

(5) screen 8 122  
(length) (depth to top)  
4 plastic  
(size) (material)

(6) pump 1/2 10  
(HP) (yield gpm)  
ala  
(type power)

(7) electric log ny  
(yes or no)  
ny  
(organization running log)

(8) how well bottom plugged Wood

description of formations encountered

from

to

<u>Red clay</u>	<u>0</u>	<u>20</u>
<u>Red silt</u>	<u>20</u>	<u>100</u>
<u>Red gravel</u>	<u>100</u>	<u>120</u>
<u>Coarse sand &amp; gravel</u>	<u>120</u>	<u>130</u>

**CODED**


DRILLERS REMARKS:

MISS. L  
WATER CO.

OCT 17 1972

If well telescopes please sketch and show depths.

GROUND LEVEL

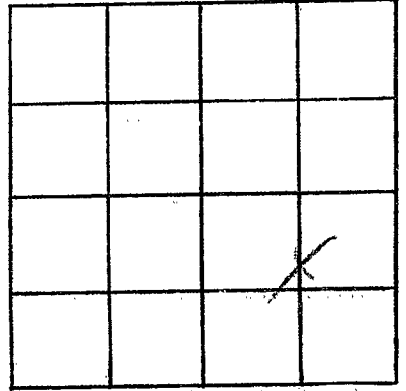

SECTION 1

Please indicate well location X.

ADDITIONAL INFORMATION

If more than one screen, show locations of each on sketch.