

MISSISSIPPI
BOARD OF WATER COMMISSIONERS
416 North State Street
Jackson, Mississippi 39201

CODED

WATER WELL DRILLERS LOG

Pike
K 62
10-31-72

Oct 31 1972 date well completed
Chertok-Reeves firm name
Pike county well located

LANDOWNER: Chertok-Reeves
address:
RFD-
(mailing address)

description of formations encountered	from	to
Red clay	0	1.5
Red sand	1.5	6.3
Red chalk	6.3	8.7
Sand & gravel	8.7	10.9

WELL LOCATION:
sec 20 T 1 N R 7 E
3 1/2 miles W of Osyka
(distance) (direction) (nearest town)

WELL PURPOSE: Home
(home, irrigation, municipal, industrial)

- WELL COMPLETION DATA:
- (1) diameter (inches) 4"
 - (2) total depth (feet) 10.9
 - (3) static water level (feet) 60 below/above top of ground.
 - (4) casing Root Bottom
(material) (depth)
 - (size) if telescope see back.
 - (5) screen 6' 10.3
(length) (depth to top)
 - 4" Plast
(size) (material)
 - (6) pump 1/2 Sub 12
(HP) (yield gpm)
 - Electric
(type power)
 - (7) electric log No
(yes or no)
 - (organization running log)

CODED


(8) how well bottom plugged
wooden plug

DRILLERS REMARKS:
New house

SEARCHED INDEXED
SERIALIZED FILED

If well telescopes please sketch and show depths.

GROUND LEVEL

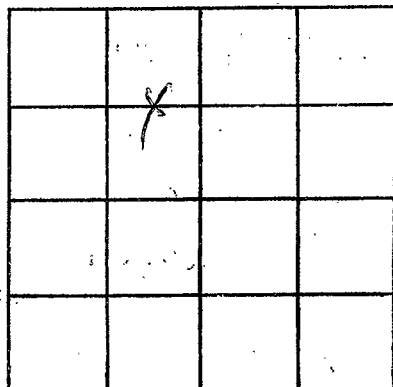

SECTION 20

Please indicate well location X.

ADDITIONAL INFORMATION

If more than one screen,
show locations of each on sketch.