

Pike  
K 63  
11-8-72

MISSISSIPPI  
BOARD OF WATER COMMISSIONERS  
416 North State Street  
Jackson, Mississippi 39201

**CODED**

WATER WELL DRILLERS LOG

Nov 8 1972 Chester Reeves Pike  
date well completed firm name county well located

LANDOWNER Jesse Lewis  
RT 2  
Oxyha -  
(mailing address)

description of formations encountered	from	to
Red clay	0	16
Red sand	16	52
Sand gravel	52	68
Chalk	68	74
Small gravel & sand	74	84

WELL LOCATION:  
sec. 20 T L N R 7 E  
4 miles W of Oxyha  
(distance) (direction) (nearest town)

WELL PURPOSE: Home  
(home, irrigation, municipal, industrial)

- WELL COMPLETION DATA:
- (1) diameter (inches) 4"
  - (2) total depth (feet) 96
  - (3) static water level (feet) 60 below top of ground.
  - (4) casing Plastic ballast  
(material) (depth)
  - (size) if telescope see back.
  - (5) screen 6" 90"  
(length) (depth to top)  
4" Plastic  
(size) (material)
  - (6) pump 1/2 12  
(HP) (yield gpm)  
Electric  
(type power)
  - (7) electric log NO  
(yes or no)
  - (organization running log)


**CODED**

(8) how well bottom plugged wooden plug  
DRILLERS REMARKS: New house

NOV 13 1972

If well telescopes please sketch and show depths.

GROUND LEVEL

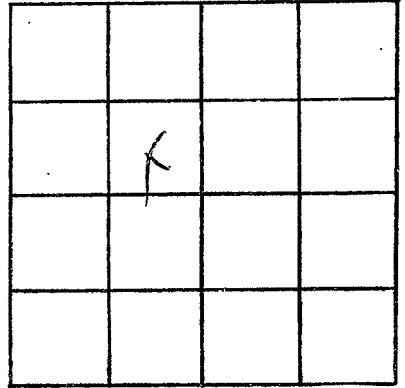

SECTION 20

Please indicate well location X.

ADDITIONAL INFORMATION

If more than one screen,  
show locations of each on sketch.