

Pike

K 64

12-28-72

MISSISSIPPI  
 BOARD OF WATER COMMISSIONERS  
 416 North State Street  
 Jackson, Mississippi 39201

CODED

WATER WELL DRILLERS LOG

Dec 28 1972 Chesterbever Reke  
 date well completed firm name county well located

LANDOWNER: James  
Veely -  
RFD-Memphis -  
 (mailing address)

description of formations encountered	from	to
Clay & gravel	0	14
Sand & gravel	14	43
Sand Rock	43	45
Red chalk	45	52
Sandy sand	52	90
Sand	90	103

WELL LOCATION:  
 sec. 11 T. 1 N. R. 7 E.  
4 miles N of Osyka  
 (distance) (direction) (nearest town)

WELL PURPOSE: Home -  
 (home, irrigation, municipal, industrial)

- WELL COMPLETION DATA:
- (1) diameter (inches) 4"
  - (2) total depth (feet) 103
  - (3) static water level (feet) 41 below top of ground.
  - (4) casing Plast Ballast  
 (material) (depth)
  - \_\_\_\_\_ if telescope see back.  
 (size)
  - (5) screen 6' 97  
 (length) (depth to top)
  - 4" Plast  
 (size) (material)
  - (6) pump 1/2 HP 12  
 (HP) (yield gpm)
  - Electric  
 (type power)
  - (7) electric log NO  
 (yes or no)

CODED

\_\_\_\_\_ (organization running log)


(8) how well bottom plugged  
wooden plug

DRILLERS REMARKS:  
New house

MAR 2 1973

If well telescopes please sketch and show depths.

GROUND LEVEL

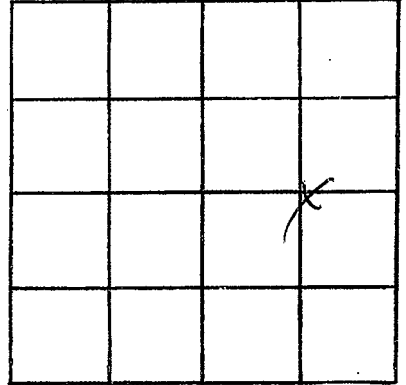

SECTION 11

Please indicate well location X.

ADDITIONAL INFORMATION

If more than one screen,  
show locations of each on sketch.