

Pike
K 65
3-21-73

MISSISSIPPI
BOARD OF WATER COMMISSIONERS
416 North State Street
Jackson, Mississippi 39201

WATER WELL DRILLERS LOG

CODED

3-21-19 73 Fitzgerald firm name Pete county well located

LANDOWNER:

Paula Dixon

R-K. Maguire
(mailing address)

WELL LOCATION:

sec. 5 T. 10 N. R. 7 E.

6 miles SW of Maguire
(distance) (direction) (nearest town)

WELL PURPOSE:

(home, irrigation, municipal, industrial) Home

WELL COMPLETION DATA:

- (1) diameter (inches) 4
- (2) total depth (feet) 136
- (3) static water level (feet) 80 below above top of ground.

(4) casing plastic 128
(material) (depth)

4 if telescope see back.
(size)

(5) screen 8 128
(length) (depth to top)

4 plastic
(size) (material)

(6) pump 1/2 10
(HP) (yield gpm)

Elva
(type power)

(7) electric log no
(yes or no)

(organization running log)

(8) how well bottom plugged completely

description of formations encountered

from to

Red Clay	0	20
Red ground	20	80
White clay	80	125
Coarse sand ground	125	136


CODED

DRILLERS REMARKS:

WELL COMPLETED
MAY 28 1973

If well telescopes please
sketch and show depths.

GROUND LEVEL

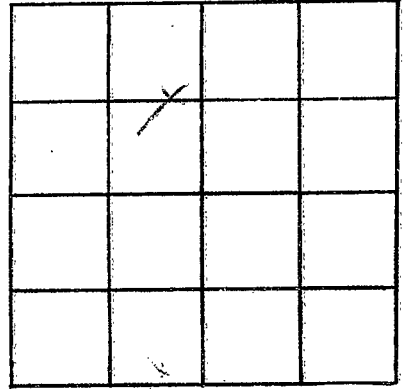

SECTION 5

Please indicate well location X.

ADDITIONAL INFORMATION

If more than one screen,
show locations of each on sketch.