

K 66
 PIKE
 8-10-73

MISSISSIPPI
 BOARD OF WATER COMMISSIONERS
 416 North State Street
 Jackson, Mississippi 39201

COPIED

WATER WELL DRILLERS LOG

8-10
 date well completed

1973 *Flynn Well Dr*
 firm name

pike
 county well located

LANDOWNER:

Robert Taylor

R.R. Moenleinomis
 (mailing address)

description of formations encountered

from

to

red clay 0 20
loam sand & gravel 20 64

WELL LOCATION:

sec. 6 T 10 N 7 E
 S W
6 miles WSE of Moening
 (distance) (direction) (nearest town)

WELL PURPOSE:

Home
 (home, irrigation, municipal, industrial)


WELL COMPLETION DATA:

- (1) diameter (inches) 4
- (2) total depth (feet) 64
- (3) static water level (feet) 28 below above top of ground.
- (4) casing plastic 56
 (material) (depth)
4 if telescope see back.
 (size)
- (5) screen 8 56
 (length) (depth to top)
4 plastic
 (size) (material)
- (6) pump 1/2 10
 (HP) (yield gpm)
EL
 (type power)
- (7) electric log no
 (yes or no)
- (organization running log)
- (8) how well bottom plugged badly

DRILLERS REMARKS:

If well telescopes please sketch and show depths.

GROUND LEVEL

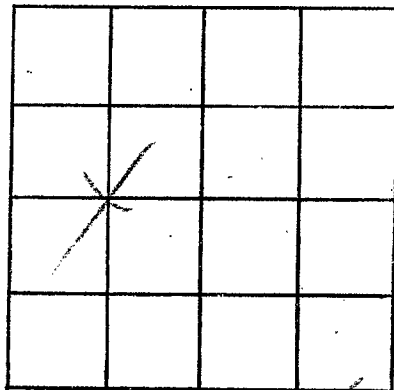

SECTION 6

Please indicate well location X.

ADDITIONAL INFORMATION

If more than one screen, show locations of each on sketch.