

PIKE

K 49 67

7-19-73

MISSISSIPPI BOARD OF WATER COMMISSION  
416 North State Street  
Jackson, Mississippi 39201

CODED

MISS. B.D. O.  
WATER COM.

WATER WELL DRILLERS LOG

19 July 1973  
date well completed

J. T. Larington  
firm name

Pike  
county well located

LANDOWNER:

R. E. McKinney

(mailing address)

WELL LOCATION:

sec. 11 T. 1 N. R. 7 E.  
2 miles NNE of Chatana  
(distance) (direction) (nearest town)

WELL PURPOSE:

(home, irrigation, municipal, industrial)

WELL COMPLETION DATA:

- (1) diameter (inches) 4
- (2) total depth (feet) 165
- (3) static water level (feet) 0 below top of ground.
- (4) casing 01 (material), 159 (depth)
- (5) screen 6 (length), 139 (depth to top)
- (6) pump (HP) (material) (yield gpm)
- (7) electric log (yes or no)
- (8) how well bottom plugged well

description of formations encountered

from to


clay dirt	0	15
sand	15	119
CLAY SAND	119	160
CLAY SAND	160	165

DRILLERS REMARKS:

Flange 6 gal per minute

If well telescopes please sketch and show depths.

GROUND LEVEL

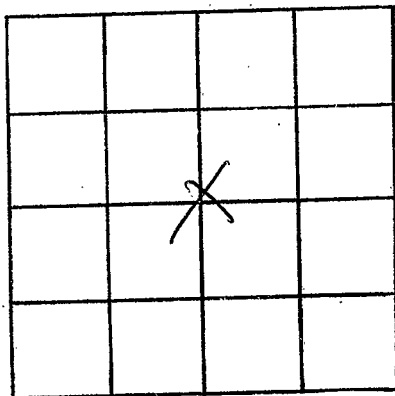

SECTION 11

Please indicate well location X.

ADDITIONAL INFORMATION

If more than one screen, show locations of each on sketch.