

PIKE
K 68
7-12-73

MISSISSIPPI
BOARD OF WATER COMMISSIONERS
416 North State Street
Jackson, Mississippi

SEP 18 1973

CODED

WATER WELL DRILLERS LOG

MISS. BD. OF WATER COMMISSIONERS

12 July 1973
date well completed

Amos Parker Well Service
firm name

county well located

LANDOWNER:
Willie Navarro

description of formations encountered	from	to
clay dirt	0	40
sand + pea gravel	40	55
chalk + sand	55	90
Red chalk	90	94
sand + pea gravel	94	108

(mailing address)
WELL LOCATION:
sec. 6 T 1 N R 7 E
10 miles S.W. of Magnolia
(distance) (direction) (nearest town)

CODED


WELL PURPOSE: Home
(home, irrigation, municipal, industrial)

- WELL COMPLETION DATA:
- (1) diameter (inches) 4
 - (2) total depth (feet) 108
 - (3) static water level (feet) 75 below above top of ground.
 - (4) casing 41 102
(material) (depth)
 - (size) if telescope see back.
 - (5) screen 4 102
(length) (depth to top)
 - (size) (material)
 - (6) pump 1/2 8
(HP) (yield gpm)
 - (type power) Electric
 - (7) electric log (yes or no)
 - (organization running log)
 - (8) how well bottom plugged wood

DRILLERS REMARKS:

If well telescopes please sketch and show depths.

GROUND LEVEL

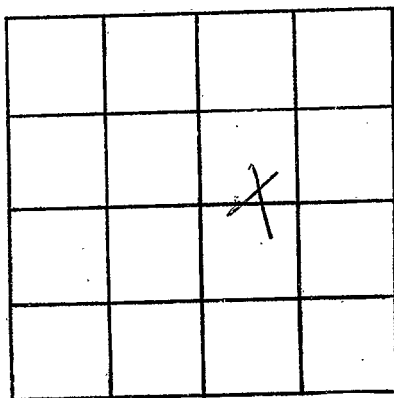

SECTION 6

Please indicate well location X.

ADDITIONAL INFORMATION

If more than one screen, show locations of each on sketch.