

PIKE
K69
4-15-74

MISSISSIPPI
BOARD OF WATER COMMISSIONERS
416 North State Street
Jackson, Mississippi 39201

CODED

WATER WELL DRILLERS LOG

4-15 1974 W. F. Henderson Inc Pike
date well completed firm name county well located

LANDOWNER:
Tommy Simmons
R.R. Osypuk
(mailing address)

description of formations encountered	from	to
<u>Red Clay</u>	<u>0</u>	<u>20</u>
<u>Red Soil</u>	<u>20</u>	<u>48</u>
<u>Coarse Sand & gravel</u>	<u>48</u>	<u>58</u>


WELL LOCATION:
sec. 30 T. 1 N. R. 7 E
4 miles W of Osypuk
(distance) (direction) (nearest town)

WELL PURPOSE: None
(home, irrigation, municipal, industrial)

WELL COMPLETION DATA:

- (1) diameter (inches) 4
- (2) total depth (feet) 58
- (3) static water level (feet) 25 below above top of ground.
- (4) casing plastic 50,
(material) (depth)
4 If telescope see back.
(size)
- (5) screen 8 50
(length) (depth to top)
4 plastic
(size) (material)
- (6) pump 1/2 10
(HP) (yield gpm)
Elco
(type power)
- (7) electric log no
(yes or no)
(organization running log)
- (8) how well bottom plugged filled

CODED

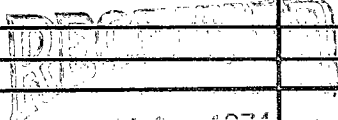


MAY 10 1974

DRILLERS REMARKS:

If well telescopes please sketch and show depths.

GROUND LEVEL

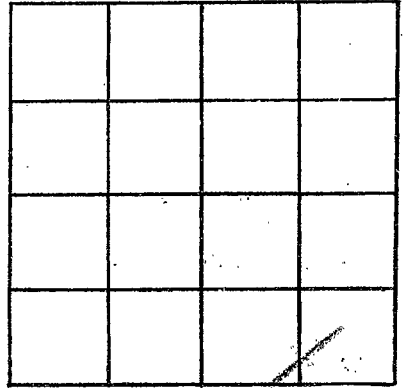

SECTION 30

Please indicate well location X.

ADDITIONAL INFORMATION

If more than one screen,
show locations of each on sketch.