

PIKE  
K 70  
3-22-74

MISSISSIPPI  
BOARD OF WATER COMMISSIONERS  
416 North State Street  
Jackson, Mississippi 39201

CODED

WATER WELL DRILLERS LOG

72 March  
date well completed

1974 J. T. Conroy & Co.  
firm name

Pike  
county well located

LANDOWNER:  
Arlan Simmons  
Osyka  
(mailing address)

description of formations encountered	from	to
clay	0	20
Redd chert	20	60
Sand Rock	60	107

WELL LOCATION:  
sec 13 T L N R 7 E  
4 miles E of Clarksdale  
(distance) (direction) (nearest town)

WELL PURPOSE:  
(home, irrigation, municipal, industrial)

WELL COMPLETION DATA:

(1) diameter (inches) 4

(2) total depth (feet) 107

(3) static water level (feet) 100 below above top of ground.

(4) casing PI, 101,  
(material) (depth)  
if telescope see back.  
(size)

(5) screen 4, 101  
(length) (depth to top)  
4, PI  
(size) (material)

(6) pump 1/2, 8  
(HP) (yield gpm)  
electric  
(type power)

(7) electric log \_\_\_\_\_  
(yes or no)  
(organization running log)

(8) how well bottom plugged used


CODED

DRILLERS REMARKS:  
Not Much water but good well

APR 17 1974  
MISSISSIPPI BOARD OF WATER COMMISSIONERS

If well telescopes please sketch and show depths.

GROUND LEVEL

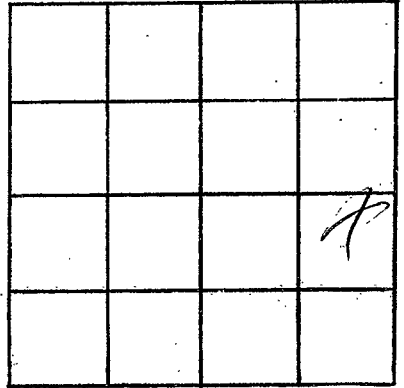

SECTION 13

Please indicate well location X.

ADDITIONAL INFORMATION

If more than one screen,  
show locations of each on sketch.