

PIKE
K 71
5-10-74

MISSISSIPPI
BOARD OF WATER COMMISSIONERS
416 North State Street
Jackson, Mississippi 39201

WATER WELL DRILLERS LOG CODED

May 10 1974 El Carroll Water Well Pike
date well completed firm name county well located

LANDOWNER:	description of formations encountered	from	to
Kary Henderson	Hard Clay	0'	40'
R 3 Box 40 Magnolia Miss (mailing address)	soft clay	40'	72'
	Rock	72'	74'
	fine sand	74'	95'
	Course Sand & Gravel	95'	107'

WELL LOCATION:

sec. 23 T. 1 N. R. 7 E.
2 miles N of Osyka
(distance) (direction) (nearest town)

WELL PURPOSE: Home
(home, irrigation, municipal, industrial)

WELL COMPLETION DATA:

- (1) diameter (inches) 2"
- (2) total depth (feet) 107'
- (3) static water level (feet) 65' below top of ground.
- (4) casing PVC 97' (material) (depth)
2" (size) if telescope see back.
- (5) screen 5' 102' (length) (depth to top)
2" PVC (size) (material)
- (6) pump 1 12 (HP) (yield gpm)
elect. (type power)
- (7) electric log no (yes or no)

(organization running log)

(8) how well bottom plugged
plastic cap


DRILLERS REMARKS:

CODED

MAY 31 1974
MISS. BD. OF WATER COMMISSIONERS

If well telescopes please sketch and show depths.

GROUND LEVEL

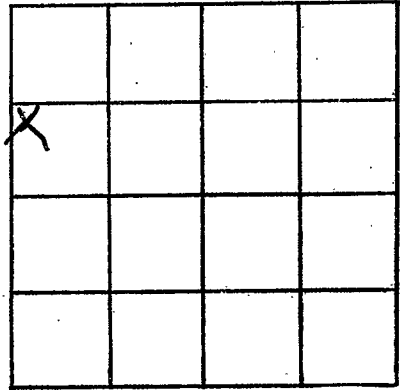

SECTION 23

Please indicate well location X.

ADDITIONAL INFORMATION

If more than one screen, show locations of each on sketch.