

PIKE
K 73
5-14-74

MISSISSIPPI
BOARD OF WATER COMMISSIONERS
416 North State Street
Jackson, Mississippi 39201

WATER WELL DRILLERS LOG CODED

5/14 1974 J.T. Crayton & Son, Inc. date well completed firm name county well located

LANDOWNER: Clyde Berryhill
Osage Mesa

(mailing address)

WELL LOCATION:

sec. 11 T. 1 N. R. 2 E
L miles E of Clarksburg
(distance) (direction) (nearest town)

WELL PURPOSE:

(home, irrigation, municipal, industrial)

WELL COMPLETION DATA:

- (1) diameter (inches) 4
- (2) total depth (feet) 134
- (3) static water level (feet) 50' below top of ground
- (4) casing (material) PL (depth) 128
- (5) screen (length) 6 (depth to top) 128
- (6) pump (HP) 1 (yield gpm) 10
- (7) electric log (yes or no) glet

(organization running log)

(8) how well bottom plugged wood

description of formations encountered	from	to
Red clay	0	20
Red clay	20	40
Sand & GRAVEL	40	60
SAND	60	80
GRAVEL & Rock	80	100
Sand & GRAVEL	100	120
SAND	120	134

CODED


RECEIVED

JUL 11 1974

DRILLERS REMARKS:

If well telescopes please sketch and show depths.

GROUND LEVEL

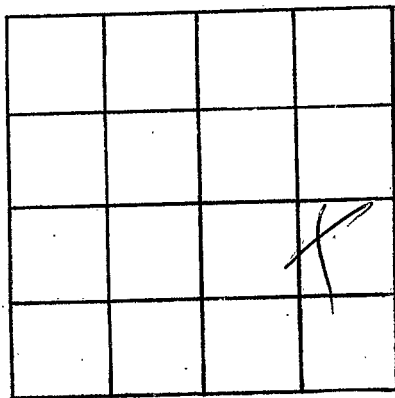

SECTION 11

Please indicate well location X.

ADDITIONAL INFORMATION

If more than one screen, show locations of each on sketch.