

PIKE
K74
9/20/74

MISSISSIPPI
BOARD OF WATER COMMISSIONERS
416 North State Street
Jackson, Mississippi 39201 **CODED**

WATER WELL DRILLERS LOG

9-20
date well completed

1974 *Flycatcher Well Serv*
firm name

Pike
Pinola
county well located


LANDOWNER:	description of formations encountered	from	to
<i>Homer Salmon</i>			
P.R. <i>Oxytoc</i> (mailing address)	<i>Red clay</i> <i>Red Sand</i> <i>Coarse Sand</i>	0 20 115	20 115 129
WELL LOCATION: sec. <u>3</u> T. <u>10</u> S. R. <u>7</u> E. W. <u>5</u> miles <u>W</u> of <u>Oxytoc</u> (distance) (direction) (nearest town)			
WELL PURPOSE: <u>flow</u> (home, irrigation, municipal, industrial)			
WELL COMPLETION DATA:			
(1) diameter (inches) <u>4</u>	CODED		
(2) total depth (feet) <u>129</u>			
(3) static water level (feet) <u>50</u> below top of ground.			
(4) casing <u>plastic</u> , <u>121</u> , (material) (depth)			
<u>4</u> (size) if telescope see back.			
(5) screen <u>8</u> , <u>121</u> (length) (depth to top)			
<u>4</u> , <u>plastic</u> (size) (material)			
(6) pump <u>1/2</u> <u>10</u> (HP) (yield gpm)			
<u>elec</u> (type power)			
(7) electric log <u>no</u> (yes or no)			
(organization running log)			
(8) how well bottom plugged <u>Sand Shok</u>			
DRILLERS REMARKS:			

RECEIVED
DIAGNOSTIC
OCT 26 1974

MISSISSIPPI BOARD OF WATER COMMISSIONERS

If well telescopes please sketch and show depths.

GROUND LEVEL

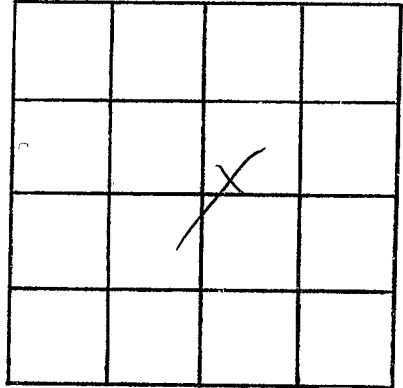

SECTION 30

Please indicate well location X.

ADDITIONAL INFORMATION

A series of horizontal lines for writing additional information.

If more than one screen, show locations of each on sketch.