

PIKE
 K 75
 8-28-74

MISSISSIPPI
 BOARD OF WATER COMMISSIONERS
 416 North State Street
 Jackson, Mississippi 39201

CODED

WATER WELL DRILLERS LOG

Aug 28 1974 *Chester Keloes* *Pike*
 date well completed firm name county well located

LANDOWNER: <i>Talman Ag. Servs. Rt 2, Oxyba</i>	description of formations encountered	from	to
	<i>Red Clay</i>	<i>0</i>	<i>17</i>
	<i>Red Sand</i>	<i>17</i>	<i>58</i>
(mailing address)	<i>Sand & Small gravel</i>	<i>58</i>	<i>72</i>
WELL LOCATION: sec <i>31</i> T <i>1</i> N R <i>7</i> E <i>4 1/2</i> miles <i>W</i> of <i>Oxyba</i>	<i>Chalky Chalk</i>	<i>72</i>	<i>100</i>
(distance) (direction) (nearest town)	<i>Small gravel Sand</i>	<i>100</i>	<i>110</i>

WELL PURPOSE: *house*
 (home, irrigation, municipal, industrial)

- WELL COMPLETION DATA:
- (1) diameter (inches) *4*
 - (2) total depth (feet) *110*
 - (3) static water level (feet) *65* below top of ground
 - (4) casing *Plast. Bottom*
(material) (depth)
_____ if telescope see back.
(size)
 - (5) screen *6"* *104*
(length) (depth to top)
4" *Plast*
(size) (material)
 - (6) pump *1* *Hydramat*
(HP) (yield gpm)
float
(type power)
 - (7) electric log *NO*
(yes or no)
 - _____ (organization running log)
 - (8) how well bottom plugged *wooden plug*


DRILLERS REMARKS:
New location

RECEIVED
 AUG 31 1974

MISS. Bd. OF WATER COMMISSIONERS

If well telescopes please sketch and show depths.

GROUND LEVEL

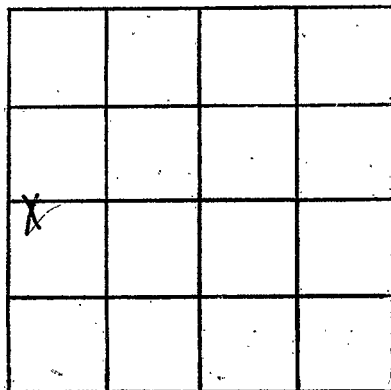

SECTION 31

Please indicate well location X.

ADDITIONAL INFORMATION

If more than one screen, show locations of each on sketch.