

PIKE
K76
2-20-75

MISSISSIPPI
BOARD OF WATER COMMISSIONERS
416 North State Street
Jackson, Mississippi 39201

COF

WATER WELL DRILLERS LOG

2-20 1975 Fitzgerald Well Serv Pike
date well completed firm name county well located



LANDOWNER:	description of formations encountered	from	to
<u>F. B. Honea</u>			
<u>R. R. Magnolia</u> (mailing address)	<u>Red clay</u>	<u>0</u>	<u>20</u>
	<u>Red sand</u>	<u>20</u>	<u>172</u>
	<u>White, Red, Blue, grey chalk</u>	<u>172</u>	<u>365</u>
	<u>Coarse sand</u>	<u>365</u>	<u>374</u>
WELL LOCATION: sec. <u>3</u> T <u>1</u> (N) R <u>7</u> (E) <u>3</u> miles (distance) <u>S</u> (direction) of <u>Myrtle</u> (nearest town)			
WELL PURPOSE: (home, irrigation, municipal, industrial) <u>Home</u>			
WELL COMPLETION DATA:			
(1) diameter (inches) <u>4 1/2</u>			
(2) total depth (feet) <u>374</u>			
(3) static water level (feet) <u>65</u> below top of ground.			
(4) casing <u>plastic galv.</u> (material) <u>180-368</u> (depth)			
<u>4 1/2</u> (size) if telescope see back.			
(5) screen <u>6'</u> (length) <u>368</u> (depth to top)			
<u>2"</u> (size) <u>Stainless steel</u> (material)			
(6) pump <u>1/2</u> (HP) <u>10</u> (yield gpm)			
<u>Electric</u> (type power)			
(7) electric log <u>no</u> (yes or no)			
(organization running log)			
(8) how well bottom plugged <u>hard shell</u>			

RECEIVED
APR - 2 1975

DRILLERS REMARKS:

If well telescopes please
sketch and show depths.

GROUND LEVEL

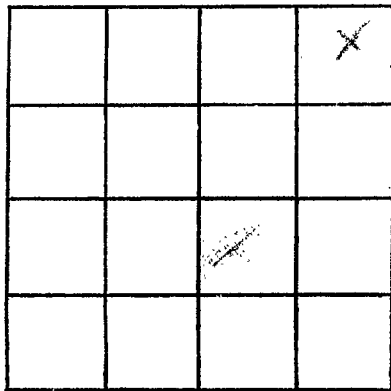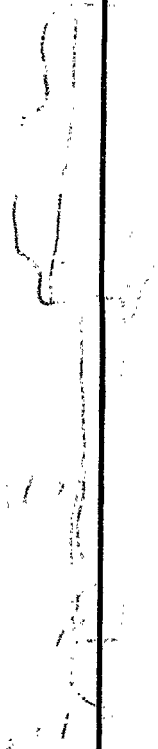

SECTION 2

Please indicate well location X.

ADDITIONAL INFORMATION

A series of horizontal lines for recording additional information, spanning the width of the right column.

If more than one screen,
show locations of each on sketch.