

K 77
Pike
4/25/75

MISSISSIPPI
BOARD OF WATER COMMISSIONERS
 416 North State Street
 Jackson, Mississippi 39201

CODED

WATER WELL DRILLERS LOG


4-25 19 75 Fitzgerald Well Serv Pike
 date well completed firm name county well located

LANDOWNER:	description of formations encountered	from	to
<u>Frank Owens</u>			
<u>R.R. Magnolia, Miss.</u> (mailing address)	<u>Red Clay</u>	<u>0</u>	<u>20</u>
	<u>Red ground</u>	<u>20</u>	<u>90</u>
	<u>Red Sand</u>	<u>90</u>	<u>125</u>
	<u>Coarse Sand & gravel</u>	<u>125</u>	<u>137</u>
WELL LOCATION:			
sec. <u>1</u> T. <u>1</u> N. R. <u>7</u> E <small>as Sec. as West</small>			
<u>4</u> miles <u>S</u> of <u>Magnolia</u> <small>(distance) (direction) (nearest town)</small>			
WELL PURPOSE: <u>Home</u> <small>(home, irrigation, municipal, industrial)</small>			
WELL COMPLETION DATA:			
(1) diameter (inches) <u>4</u>			
(2) total depth (feet) <u>137</u>			
(3) static water level (feet) <u>25</u> below <small>top of ground.</small> <u>above</u>			
(4) casing <u>plastic</u> , <u>129</u> , <small>(material) (depth)</small>			
<u>4</u> <small>(size)</small> if telescope see back.			
(5) screen <u>8</u> , <u>129</u> <small>(length) (depth to top)</small>			
<u>4</u> , <u>plastic</u> <small>(size) (material)</small>			
(6) pump <u>1/2</u> , <u>10</u> <small>(HP) (yield gpm)</small>			
<u>4hp</u> <small>(type power)</small>			
(7) electric log <u>ny</u> <small>(yes or no)</small>			
<u>ny</u> <small>(organization running log)</small>			
(8) how well bottom plugged. <u>Seal shut</u>			
DRILLERS REMARKS:			

REGISTERED
APR 20 1975
MISS. Bd. OF WATER COMMISSIONERS

If well telescopes please sketch and show depths.

GROUND LEVEL

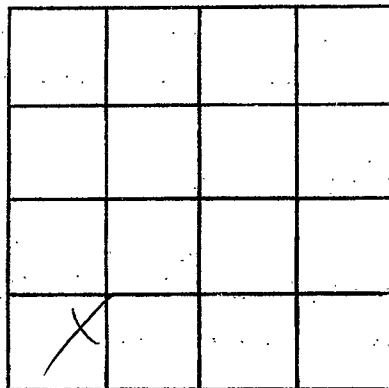

SECTION 1

Please indicate well location X.

ADDITIONAL INFORMATION

If more than one screen, show locations of each on sketch.