

Pipe  
K 78  
4-29-75

MISSISSIPPI  
BOARD OF WATER COMMISSIONERS  
416 North State Street  
Jackson, Mississippi 39201

CODED

WATER WELL DRILLERS LOG

April 29 1975 Chestnut Rivers Pipe  
date well completed firm name county well located

LANDOWNER:  
Curtiss Johnston  
Rt. 2584  
(mailing address)

description of formations encountered	from	to
Red sandy clay	0	22
sand & gravel	22	42
gravel	42	52
Mid chalk	52	110
Coarse sand	110	122

WELL LOCATION:  
sec 20 T 1 N R 7 E 14H  
2 1/2 miles N-W of Osyka  
(distance) (direction) (nearest town)

WELL PURPOSE: Reseal  
(home, irrigation, municipal, industrial)

WELL COMPLETION DATA:  
(1) diameter (inches) 4"  
(2) total depth (feet) 122  
(3) static water level (feet) 46 below top of ground  
(4) casing plastic bottom  
(material) (depth)  
1 1/2" If telescope see back.  
(size)  
(5) screen 1 1/2"  
(length) (depth to top)  
4"  
(size) (material)  
(6) pump 1 1/2 HP 10  
(HP) (yield gpm)  
elect  
(type power)  
(7) electric log no  
(yes or no)  
(organization running log)


(8) how well bottom plugged  
no sand plug

DRILLERS REMARKS:  
new location

RECEIVED  
JUN 20 1975

If well telescopes please sketch and show depths.

GROUND LEVEL

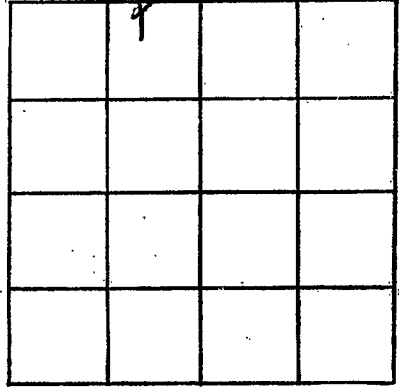

SECTION 20

Please indicate well location X.

ADDITIONAL INFORMATION

If more than one screen, show locations of each on sketch.