

Pike

K-80

7/20/80

7-20

MISSISSIPPI BOARD OF WATER COMMISSIONERS 416 North State Street Jackson, Mississippi 39201

CODED

WATER WELL DRILLERS LOG

Griner Drilling Service

Pike

date well completed

firm name

county well located

LANDOWNER: R.E. Williams P.O. Box 698 Natchez, MS 39120 (mailing address)

description of formations encountered	from	to
clay + sand	0	119
gravel + sand	119	245
sand	245	287
gravel + sand	287	392

WELL LOCATION: 500' N + 150' E of intersection of 2 1/2 mi. road towards Hillsboro, La. (nearest town)

WELL PURPOSE: (home, irrigation, municipal, industrial)

- WELL COMPLETION DATA:
- (1) diameter (inches) 3"
 - (2) total depth (feet) 392'
 - (3) static water level (feet) 50' below top of ground
 - (4) casing (material) steel, (depth) 378'
 - (size) 3" if telescope see back.
 - (5) screen (length) 42', (depth to top) 336'
 - (size) 3" (material) perforated
 - (6) pump (HP) 75 (yield gpm)
 - (type power) AC
 - (7) electric log (yes or no)
 - (organization running log)

(8) how well bottom dugged: orange peel

DRILLERS REMARKS:


DEPT. OF NATURAL RESOURCES BUREAU OF LAND & WATER RESOURCES

JUL 28 1980

RECEIVED

If well telescopes please sketch and show depths.

GROUND LEVEL

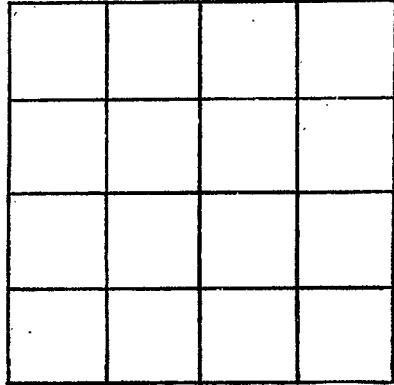

SECTION _____

Please indicate well location X.

ADDITIONAL INFORMATION

If more than one screen,
show locations of each on sketch.