

PIKE

K-81

9-14-79

MISSISSIPPI BOARD OF WATER COMMISSIONERS
416 North State Street
Jackson, Mississippi 39201

CODED

WATER WELL DRILLERS LOG

Sept-14 19 79 Pike Reuss Well Dr. Pike
date well completed firm name county well located

LANDOWNER:
Dick Claton
Rt. Osyka
(mailing address)

description of formations encountered	from	to
<u>Red clay</u>	<u>0</u>	<u>21</u>
<u>Yellow sand</u>	<u>21</u>	<u>70</u>
<u>Gravel</u>	<u>70</u>	<u>100</u>
<u>Lightly sand</u>	<u>100</u>	<u>110</u>
<u>sand & peb. gravel</u>	<u>110</u>	<u>130</u>

WELL LOCATION:
27 Sec 1 T 1 N R 7 E
1 miles N-NW of Osyka
(distance) (direction) (nearest town)

CODED

WELL PURPOSE: Pond
(home, irrigation, municipal, industrial)

- WELL COMPLETION DATA:
- (1) diameter (inches) 4"
 - (2) total depth (feet) 130
 - (3) static water level (feet) 130 below top of ground.
 - (4) casing plastic bottom
(material) (depth)
 - (size) if telescope see back.
 - (5) screen 10' 120'
(length) (depth to top)
 - 4" plastic
(size) (material)
 - (6) pump 2 sub 20
(HP) (yield gpm)
 - shut
(type power)
 - (7) electric log no
(yes or no)
 - (organization running log)

(8) how well bottom plugged
Wooden plug


DRILLERS REMARKS:

DEPT. OF NATURAL RESOURCES
BUREAU OF LAND & WATER RESOURCES

SEP 2 - 1979
RECEIVED

If well telescopes please sketch and show depths.

GROUND LEVEL

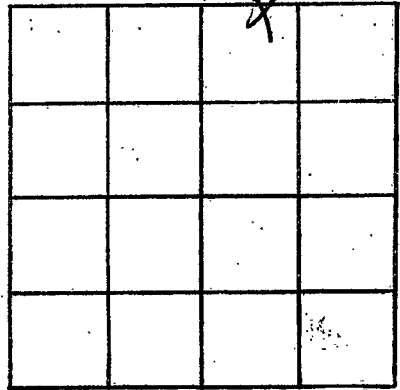

SECTION 27

Please indicate well location X.

ADDITIONAL INFORMATION

If more than one screen, show locations of each on sketch.