

MISSISSIPPI DEPARTMENT OF NATURAL RESOURCES

Bureau of Land and Water Resources

Southport Mall

P.O. Box 10631

Jackson, Mississippi 39209

WATER WELL DRILLERS LOG

**CODED**

K83
Pike
9-9-83

*Griner Drilling Service, Inc.*

*Pike*

9-9-83  
date well completed

Griner Drilling Service, Inc.  
firm name

Pike  
county well located

LANDOWNER:	description of formations encountered	from	to
<i>Justiss Oil</i>	<i>sand, gravel</i>	<i>0</i>	<i>80</i>
<i>B.O. Box N</i>	<i>sand, pea gravel</i>	<i>80</i>	<i>260</i>
<i>Jena, La. 71341</i>	<i>clay</i>	<i>260</i>	<i>273</i>
(mailing address)			
WELL LOCATION: <i>500's + 500'e of</i>			
<i>sec. 10 T-1 R-7</i>			
<i>No. 101</i>			
<i>Chatauga Field</i>			
(direction) (nearest town)			
WELL PURPOSE: <i>oil field supply</i>			
(home, irrigation, municipal, industrial)			
WELL COMPLETION DATA:			
(1) diameter (inches) <i>3"</i>			
(2) total depth (feet) <i>273'</i>			
(3) static water level (feet) <i>70'</i> <input checked="" type="checkbox"/> below <input type="checkbox"/> above top of ground.			
(4) casing <i>Steel, 252'</i>			
(material) (depth)			
<i>3"</i>			
(size) if telescope see back.			
(5) screen <i>42'</i> , <i>210'</i>			
(length) (depth to top)			
<i>3"</i> , <i>perforated</i>			
(size) (material)			
(6) pump <i>—</i> , <i>70-75</i>			
(HP) (yield gpm)			
<i>AC</i>			
(type power)			
(7) electric log <i>—</i>			
(yes or no)			
(organization running log)			
(8) how well bottom plugged <i>orange peel</i>			
DRILLERS REMARKS:			


DEPT. OF NATURAL RESOURCES  
BUREAU OF LAND & WATER RESOURCES

OCT 9 1983

RECEIVED

If well telescopes please sketch and show depths.

GROUND LEVEL

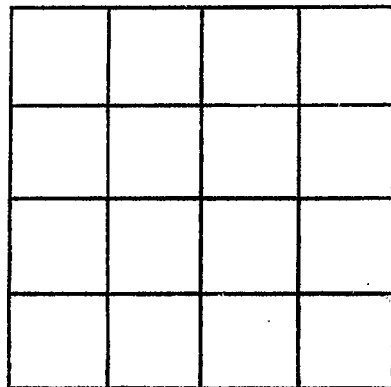

SECTION \_\_\_\_\_

Please indicate well location X.

ADDITIONAL INFORMATION

If more than one screen,  
show locations of each on sketch.