

MISSISSIPPI DEPARTMENT OF NATURAL RESOURCES

Bureau of Land and Water Resources

Southport Mall

P.O. Box 10631

Jackson, Mississippi 39209

WATER WELL DRILLERS LOG

K90
Pike

4-25-85 19
date well completed

Stafford Water Well
firm name

Pike Co.
county well located

LANDOWNER: Bob Stull
No. 1
Cyfra, Ms. 39658
(mailing address)

WELL LOCATION:
sec. 1 T-1 N S R-7 E W
7 miles south of Maguach
(distance) (direction) (nearest town)

WELL PURPOSE: home
(home, irrigation, municipal, industrial)

WELL COMPLETION DATA:

(1) diameter (inches) 4 1/2"
(2) total depth (feet) 72'
(3) static water level (feet) 57' below above top of ground.
(4) casing plastic 72'
(material) (depth)
(size) if telescope see back.
(5) screen 10' 62'
(length) (depth to top)
4' plastic
(size) (material)
(6) pump 1/2 114
(HP) (yield gpm)
electric
(type power)
(7) electric log (yes or no)
(organization running log)
(8) how well bottom plugged sand
shank

description of formations encountered	from	to
<u>top soil</u>	<u>0</u>	<u>1'</u>
<u>red sand</u>	<u>1'</u>	<u>52'</u>
<u>pea gravel</u>	<u>50'</u>	<u>60'</u>
<u>water sand & gravel</u>	<u>60'</u>	<u>72'</u>


RECEIVED
MAY - 9 1985

DRILLERS REMARKS: Well been
assembled by Shelby Stafford

Department of Natural Resources
Bureau of Land & Water Resources

If well telescopes please sketch and show depths.

GROUND LEVEL

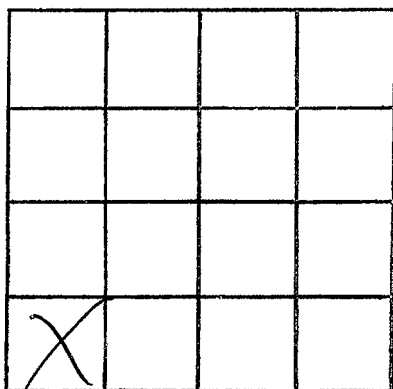

SECTION 1

Please indicate well location X.

ADDITIONAL INFORMATION

If more than one screen,
show locations of each on sketch.