State V	Well Report	
County: Pike Part 1 -	Part 1 - Driller's Log	
Mississippi Departm	ent of Environmental Quality Aquifer: 4.1.1.3	
	and Water Resources V Box 2309 Well #:	
	on MS 39225	
	L. S. Elevation:	
Date drilling completeu: <u>6.077777</u> (601)9	61- 5228 (fax) E-log #:	
State Law requires that this report be prepared by the l	icense holder responsible for the work and filed with the	
Department at the above address within 30 days of con	npletion of drilling of the well or borehole.	
Information on Well Owner	Well or Borehole Location	
(Landowner if borehole is not for a water well)	Latitude: 31. 3' 39.2 "Longitude: 20°. 27', 45.5"	
Owner Name Tessica Reever	20 11	
	Method of Lat/Long (circle one): Conventional Survey, $4k$	
Mailing Address: Old Huy SI	USGS quad, Hand-heid GPS, Survey-grade GPS	
Ch. L. a.C.	512 1/ 522 1/2 Sec_12_ Twn_1N Rng 7E	
<u>Charlana</u> <u>MS</u> , City State Zip Code	Distance Direction Nearest Town	
Telephone No. ()	Miles of	
	rehole Data	
Date drilling started: 8-29-11 Date drilling completed: 8-29-11 Hole depth: 135 Hole diameter: 8/1		
Leasting of the source of any surface water used for drilling		
Location of the source of any surface water used for drilling:		
Logs run (circle all applicable): No log run Electric Gamma Ray Density Sonic Neutron Other:		
Purpose of borehole (check one): Water Well Geotechnical/Geological Investigation Ground Source Heat Pump		
Seismic SurveyOther (<i>describe</i>)		
If drilling is not related to water well construction, skip the remainder of this block		
Purpose of Well (check one): Home <u></u>		
If a flowing well, method of flow regulation: Valve Other (describe)		
Static Water Level:feet above or below (circle one) land surface Date measured:		
Method of Measurement (circle one) steel tape electric tape air line other:		
Well depth: <u>135</u> Well grouted to a depth of <u>10</u> feet Type of grout (circle one): Neat Cement Bentonite Mix		
Casing length: <u>125</u> feet Casing diameter: <u>4^{'''}</u> inches Type of casing: <u><i>Puc</i></u>		
Screen length: <u>10</u> feet Screen diameter: <u>9</u> inches Type of screen: <u>pro</u>		
Screen slot size: <u>2012</u> inches Setting depth: From <u>135</u> feet to <u>135</u> feet		
Type of completion (circle all applicable): Gavel packed Underreamed Telescoped Open hole Natural Development		
Other (describe):		
Top of lap pipe or reduction in casing:feet. If telescoped or more than one screen, describe on next page		
Form: OLWR-SWR-1A (04		

e 🔶


RECEIVED SEP 0 7 2011 37: October The sketch below only required for water wells

If well telescopes, show depths on sketch. Ground Level_

Description of formations encountered must be provided for all wells and boreholes, unless specifically exempted by regulations

Description of Formations Encountered	From (depth)	
	Ground Level	
Cluip	0	20
ciduel.	20	40
Sand	40	80
Clay	80	110
Saudi	ko	120
Course Sand	120	135

If more than one screen, show location of each on sketch

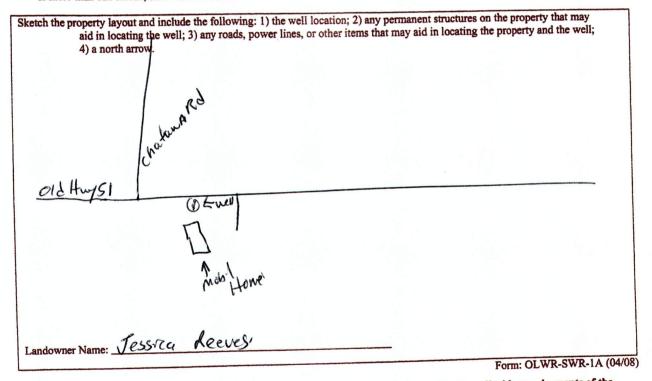

I certify that the well/borehole was drilled, constructed, and completed in accordance with all applicable requirements of the Mississippi Department of Environmental Quality and the Mississippi Department of Health regulations, if applicable, and state

8-29-11 laws BIAZ Forguald Date

Print Name of Responsible Licensee and License No.

Signature of Licensee

RECEIVED SEP 0 7 2011 BY: OLMR

County: IKe Permit #:	ELL REPORT Part 2 's Completion Report nt of Environmental Quality and Water Resources Box 2309 n, MS 39225 1)961-5210 61-5228 (fax)
This part of the report must be completed by a licensed water well	contractor or a licensed pump installer. A copy of Part 1 of the
This part of the report must be completed by a licensed while when report must be attached and both parts filed with the Department Well Owner Information	Well Location
Owner Name: Jessica Reeves	Latitude: 31° 3' 39.2" Longitude: 90° 27' 45.5
Mailing Address: Old HwySI	Method of Lat/Long (check one): Conventional Survey
Mailing Address:Ord_ II any a f	USGS quad, Hand-held GPS, Survey-grade GPS
ch h a ms.	<u>4 4 Sec 12 T /N R 7E</u>
Chartant MS. City State Zip Code	
Telephone No. ()	Distance Direction Nearest lown
Pump Type	Power Type Circle one
Air Lift Jet Submersible	Diesel Engine Gasoline Engine Natural Gas
Bucket Piston Turbine	Electric Motor, Hand Tractor PTO
Centrifugal Rotary Flowing Well	Windmill Other (specify):
Other (specify):	Horse Power Rating of Motor:
Date Pump Installed: 8-24-11	Setting Depth:feet
Rated Pump Capacity:Gallons Per Minute	Number of Stages:
Rated Pump Capacity:Guilous I di Anticio	
Pump Test Data	Method of Mensuring Water Level Circle one
Date Well Tested:	Air Line Electric Measuring Line Steel Tape
Static Water Level (A):Feet Below Land Surface	Other (specify):
Pumping Water Level (B):Feet Below Land Surface	
Drawdown [(B) - (A)]:Feet Below Land Surface	For flowing well, measured shut in head:feet
Test Pumping Rate:Gallons Per Minute	Well yielded GPM with a drawdown of
Duration of Pump Test (minimum 4 hours):hours	feet afterhours of pumping
This is for (circle one): New Well Replacement of	Existing Pump Repair of Existing Pump
I HEREBY CERTIFY that the above statements are true to the be	st of my knowledge.
BIAJ FIZZUALO 029-	But Fld
Print Name of Pump Installer and License No. (if applicable)	Signature of Pump Installer Form: OLWR-SWR-1C (07-0
	SEP 0 7 2
	DV. AH
	BY: OL