

PIKE
K 2000
12-4-75

MISSISSIPPI
BOARD OF WATER COMMISSIONERS
416 North State Street
Jackson, Mississippi 39201

WATER WELL DRILLERS LOG

11 Dec 1975 date well completed
144 Annapolis Wells firm name
Pike county well located

LANDOWNER:
James Oliver
Magnolia Miss
(mailing address)

description of formations encountered	from	to
clay	0	70
gulf clay	70	27
gulf shale	27	60
chert	60	70
crust	70	102

WELL LOCATION:
sec. 6 T. 1 N. R. 7 E. S. W.
5 miles SW of Mage
(distance) (direction) (nearest town)

WELL PURPOSE:
(home, irrigation, municipal, industrial)


- WELL COMPLETION DATA:
- (1) diameter (inches) ~~4~~ 4
 - (2) total depth (feet) 102
 - (3) static water level (feet) 85 below top of ground.
 - (4) casing (material) PL (depth) 9.6
(size) If telescope see back.
 - (5) screen (length) 6 (depth to top) 9.6
(size) 4 (material) PL
 - (6) pump (HP) 2 (yield gpm) 8
(type power) 220V
 - (7) electric log (yes or no)
 - (organization running log)
 - (8) how well bottom plugged wood

DRILLERS REMARKS:

MISSISSIPPI
FEB 23 1976
MISS. Bd. OF WATER COMMISSIONERS

If well telescopes please sketch and show depths.

GROUND LEVEL

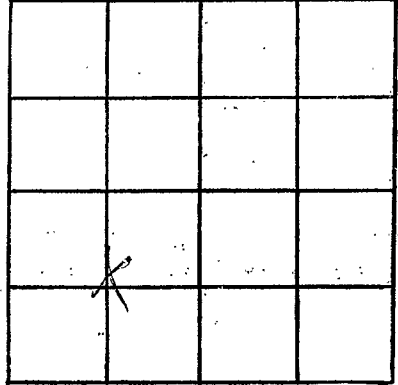

SECTION 6

Please indicate well location X.

ADDITIONAL INFORMATION

If more than one screen, show locations of each on sketch.