


Pike
K 20021
3-19-76

MISSISSIPPI
 BOARD OF WATER COMMISSIONERS
 416 North State Street
 Jackson, Mississippi 39201

WATER WELL DRILLERS LOG

3-19 1976 Fitzgibbon & Sons Pike
 date well completed firm name county well located


LANDOWNER:	description of formations encountered	from	to
<u>Clyde Roberts</u> <u>R.R. Macnolin</u> (mailing address)			
WELL LOCATION: sec. <u>6</u> T. <u>10</u> N. R. <u>7</u> E. S. W.			
<u>6</u> miles <u>SW</u> of <u>Marion</u> (distance) (direction) (nearest town)			
WELL PURPOSE: <u>Home</u> (home, irrigation, municipal, industrial)			
WELL COMPLETION DATA:			
(1) diameter (inches) <u>4</u>			
(2) total depth (feet) <u>92</u>			
(3) static water level (feet) <u>45</u> below top of ground.			
(4) casing <u>PVC</u> , <u>84</u> (material) (depth)			
<u>4</u> If telescope see back. (size)			
(5) screen <u>8</u> , <u>84</u> (length) (depth to top)			
<u>4</u> , <u>PVC</u> (size) (material)			
(6) pump <u>1/2</u> , <u>10</u> (HP) (yield gpm)			
<u>Electric</u> (type power)			
(7) electric log <u>no</u> (yes or no)			
(organization running log)			
(8) how well bottom plugged <u>Level block</u>			
DRILLERS REMARKS:			

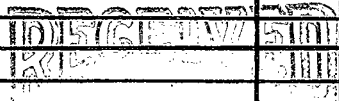

APR - 7 1976

If well telescopes please sketch and show depths.

GROUND LEVEL

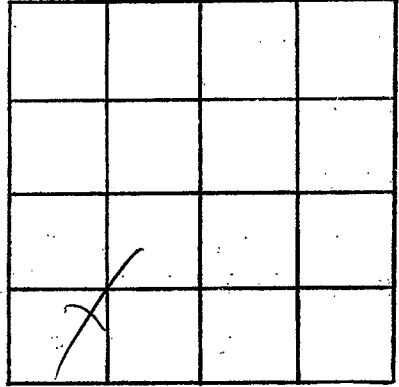

SECTION 6

Please indicate well location X.

ADDITIONAL INFORMATION

If more than one screen, show locations of each on sketch.