

Pike  
R 2003  
4-15-76

MISSISSIPPI  
 BOARD OF WATER COMMISSIONERS  
 416 North State Street  
 Jackson, Mississippi 39201

WATER WELL DRILLERS LOG

15 April 1976 <sup>14H</sup> J.T. Crumpton Pike  
 date well completed firm name county well located

LANDOWNER:  
Paul Ford  
Magrath  
 (mailing address)

description of formations encountered	from	to
<u>clay</u>	<u>0</u>	<u>15</u>
<u>sand</u>	<u>15</u>	<u>45</u>
<u>Chickasaw</u>	<u>45</u>	<u>80</u>
<u>Blind</u>	<u>80</u>	<u>94</u>

WELL LOCATION:  
 sec. 8 T 1 N R 7 E  
6 miles SW of Magrath  
 (distance) (direction) (nearest town)

WELL PURPOSE:  
 (home, irrigation, municipal, industrial)


- WELL COMPLETION DATA:
- (1) diameter (inches) 4
  - (2) total depth (feet) 94
  - (3) static water level (feet) 70 below top of ground.
  - (4) casing PI 98  
 (material) (depth)  
 (size) if telescope see back.
  - (5) screen 6 98  
 (length) (depth to top)  
4 PI  
 (size) (material)
  - (6) pump 1/2 5  
 (HP) (yield gpm)  
elect  
 (type power)
  - (7) electric log                       
 (yes or no)
  - (8) how well bottom plugged good

DRILLERS REMARKS:

JUL 22 1976  
 MISSISSIPPI BOARD OF WATER COMMISSIONERS

If well telescopes please sketch and show depths.

GROUND LEVEL

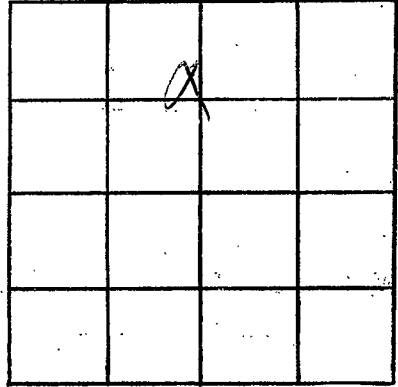

SECTION 8

Please indicate well location X.

ADDITIONAL INFORMATION

Lined area for additional information.

If more than one screen, show locations of each on sketch.