

Pike  
R 2008  
9-15-76

MISSISSIPPI  
 BOARD OF WATER COMMISSIONERS  
 416 North State Street  
 Jackson, Mississippi 39201


WATER WELL DRILLERS LOG

9-15 1976 F. L. ... Service Pike  
 date well completed firm name county well located

LANDOWNER:	description of formations encountered	from	to
<u>W. James Welch</u>			
<u>R.R. Oyster</u> (mailing address)	<u>Red sand</u>	<u>20</u>	<u>40</u>
WELL LOCATION:	<u>Red gravel</u>	<u>70</u>	<u>75</u>
sec. <u>30</u> T. <u>1</u> N. R. <u>7</u> E	<u>Red sand</u>	<u>75</u>	<u>180</u>
<u>3 1/2</u> miles <u>W</u> of <u>Osyka</u>	<u>Coarse sand &amp; gravel</u>	<u>180</u>	<u>192</u>
(distance) (direction) (nearest town)			
WELL PURPOSE: (home, irrigation, municipal, industrial)			
<u>Home</u>			
WELL COMPLETION DATA:			
(1) diameter (inches) <u>4</u>			
(2) total depth (feet) <u>192</u>			
(3) static water level (feet) <u>50</u> below top of ground.			
(4) casing <u>P.V.C.</u> <u>184</u> (material) (depth)			
<u>4</u> If telescope see back. (size)			
(5) screen <u>8</u> <u>184</u> (length) (depth to top)			
<u>4</u> <u>P.V.C.</u> (size) (material)			
(6) pump <u>1/2</u> <u>10</u> (HP) (yield gpm)			
<u>elec</u> (type power)			
(7) electric log <u>no</u> (yes or no)			
(organization running log)			
(8) how well bottom plugged <u>Sand plug</u>			
DRILLERS REMARKS:			

If well telescopes please sketch and show depths.

GROUND LEVEL

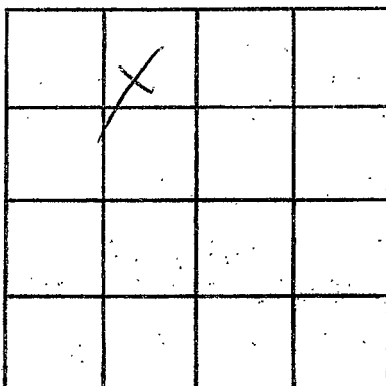

SECTION 30

Please indicate well location X.

ADDITIONAL INFORMATION

If more than one screen,  
show locations of each on sketch.