

Pike  
K 2002  
10/29/76

MISSISSIPPI  
BOARD OF WATER COMMISSIONERS  
416 North State Street  
Jackson, Mississippi 39201

14H

WATER WELL DRILLERS LOG

Oct 29 1976 Remusville Pike  
date well completed firm name county well located


LANDOWNER:	description of formations encountered	from	to
<u>Elliott DeBlance</u>	<u>Clay</u>	<u>0</u>	<u>12</u>
<u>At 2 Osyka</u> (mailing address)	<u>fine sand</u>	<u>12</u>	<u>50</u>
	<u>blue chalk</u>	<u>50</u>	<u>158</u>
	<u>Coarse sand</u>	<u>158</u>	<u>181</u>
WELL LOCATION: sec. <u>20</u> T <u>1</u> N R <u>7</u> E <u>3</u> miles <u>N-W of</u> <u>Osyka</u> (distance) (direction) of (nearest town)			
WELL PURPOSE: <u>House</u> (home, irrigation, municipal, industrial)			
WELL COMPLETION DATA:			
(1) diameter (inches) <u>4</u>			
(2) total depth (feet) <u>181</u>			
(3) static water level (feet) <u>30</u> below above top of ground.			
(4) casing <u>plastic bottom</u> (material) (depth)			
<u>        </u> If telescope see back. (size)			
(5) screen <u>6"</u> <u>175'</u> (length) (depth to top)			
<u>4"</u> <u>plastic</u> (size) (material)			
(6) pump <u>by others</u> (HP) (yield gpm)			
<u>chest</u> (type power)			
(7) electric log <u>no</u> (yes or no)			
(organization running log)			
(8) how well bottom plugged <u>was drilled by</u>			
DRILLERS REMARKS: <u>old well hit by lightning</u>			

**RECEIVED**  
FEB - 4 1977

MISS. BD. OF WATER COMMISSIONERS

If well telescopes please sketch and show depths.

GROUND LEVEL

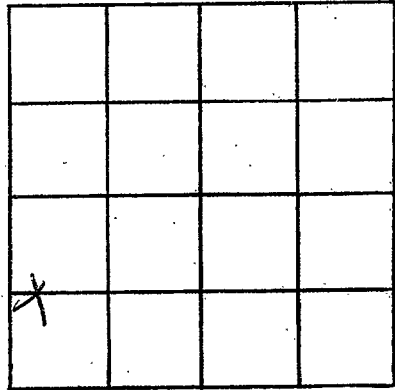

SECTION 20

Please indicate well location X.

ADDITIONAL INFORMATION

If more than one screen, show locations of each on sketch.