

Pike  
 R 2010  
 12/29/76

MISSISSIPPI  
 BOARD OF WATER COMMISSIONERS  
 416 North State Street  
 Jackson, Mississippi 39201

WATER WELL DRILLERS LOG

Dec 29 1976  
 date well completed

144 Peaves weller  
 firm name

Pike  
 county well located

LANDOWNER:  
 Louisa Coleman  
 P.O. 1 - Osceola  
 (mailing address)

description of formations encountered	from to	
	feet	feet
Red Clay	0	22
Red sand	22	68
Red Chalky sand	68	80
Sandstone	80	108

WELL LOCATION:  
 sec. 1 T. 1 N R. 7 E  
 4 miles South of Magnolia  
 (distance) (direction) (nearest town)

WELL PURPOSE: Home  
 (home, irrigation, municipal, industrial)

- WELL COMPLETION DATA:
- (1) diameter (inches) 4"
  - (2) total depth (feet) 108
  - (3) static water level (feet) 97 below top of ground.
  - (4) casing Plastic Cotton (material) (depth)
  - (5) screen 6' length, 10.2' depth to top (size) (depth to top)
  - (6) pump 1/2 HP (HP) 10 yield gpm (size) (material)
  - (7) electric log no (yes or no)

(8) how well bottom plugged  
 Wooden plug


DRILLERS REMARKS:

RECEIVED  
 FEB - 7 1977

MISS. BD. OF WATER COMMISSIONERS

If well telescopes please sketch and show depths.

GROUND LEVEL

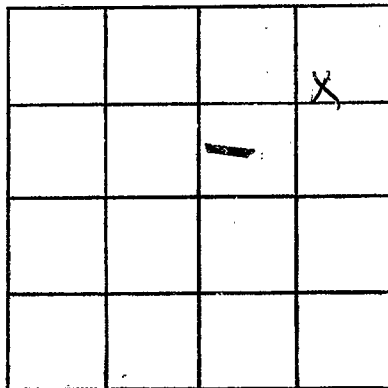

SECTION 1

Please indicate well location X.

ADDITIONAL INFORMATION

If more than one screen, show locations of each on sketch.