

Pipe  
K 200  
3/25/77

MISSISSIPPI  
BOARD OF WATER COMMISSIONERS  
416 North State Street  
Jackson, Mississippi 39201

14H

WATER WELL DRILLERS LOG

3-25  
date well completed

19 77 *Fitzgerald Label Sew*  
firm name

~~PIKE~~ PIKE  
county well located


LANDOWNER:	description of formations encountered	from	to
<p><i>John W. McDaniel</i> <i>magnolia</i> <i>R.R. K. ...</i> (mailing address)</p>			
<p>WELL LOCATION:</p> <p>sec. <u>11</u> T. <u>1</u> N. R. <u>7</u> E <u>1/2</u> miles <u>W</u> of <u>Watauga</u> (distance) (direction) (nearest town)</p>			
<p>WELL PURPOSE: (home, irrigation, municipal, industrial)</p>			
<p>WELL COMPLETION DATA:</p> <p>(1) diameter (inches) <u>4</u></p> <p>(2) total depth (feet) <u>130</u></p> <p>(3) static water level (feet) <u>50</u> below above top of ground.</p> <p>(4) casing <u>PVC</u>, <u>122</u>, (material) (depth) <u>4</u> If telescope see back. (size)</p> <p>(5) screen <u>8</u>, <u>122</u> (length) (depth to top) <u>4</u> (size) <u>PVC</u> (material)</p> <p>(6) pump <u>1/2</u>, <u>10</u> (HP) (yield gpm) <u>Electric</u> (type power)</p> <p>(7) electric log <u>Yes</u> (yes or no) (organization running log)</p> <p>(8) how well bottom plugged <u>Sand block</u></p>			
<p>DRILLERS REMARKS:</p>			

RECEIVED  
MAY 30 1977

MISS. BD. OF WATER COMMISSIONERS

If well telescopes please sketch and show depths.

GROUND LEVEL

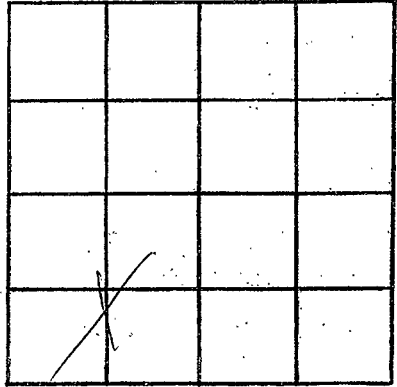

SECTION 11

Please indicate well location X.

ADDITIONAL INFORMATION

If more than one screen, show locations of each on sketch.