

Pike
 K 2012
 3/8/77

MISSISSIPPI
 BOARD OF WATER COMMISSIONERS
 416 North State Street
 Jackson, Mississippi 39201

19

WATER WELL DRILLERS LOG

March 8 1977 Reynolds Pike
 date well completed firm name county well located

LANDOWNER:
Joe DeBlance
Rt 2 Osyka
 (mailing address)

description of formations encountered	from	to
<u>Red Clay</u>	<u>0</u>	<u>10</u>
<u>Red sand</u>	<u>10</u>	<u>65</u>
<u>Sand & gravel</u>	<u>65</u>	<u>70</u>
<u>bed of Chalk</u>	<u>76</u>	<u>130</u>
<u>Coarse sand</u>	<u>130</u>	<u>140</u>

WELL LOCATION:
 sec. 18 T 1 N R. 7 E
3 miles W. N. W. of Osyka
 (distance) (direction) (nearest town)

WELL PURPOSE: Home
 (home, irrigation, municipal, industrial)

WELL COMPLETION DATA:

(1) diameter (inches) 4"

(2) total depth (feet) 140

(3) static water level (feet) 60 below above top of ground.

(4) casing plastic bottom
 (material) (depth)

— If telescope see back.
 (size)

(5) screen 5' 130'
 (length) (depth to top)

4" plastic
 (size) (material)

(6) pump 3/4 hp 1 1/2
 (HP) (yield gpm)

elec
 (type power)

(7) electric log no
 (yes or no)

—
 (organization running log)

(8) how well bottom plugged
wooden plug

DRILLERS REMARKS:
✓


RECEIVED

MAR 21 1977

MISS. BD. OF WATER COMMISSIONERS

If well telescopes please sketch and show depths.

GROUND LEVEL

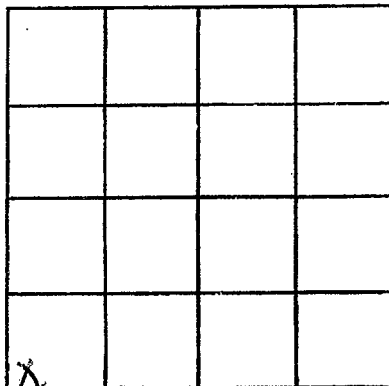

SECTION 18

Please indicate well location X.

ADDITIONAL INFORMATION

If more than one screen, show locations of each on sketch.