

Winter info  
8/5/77

Pike  
K 2013  
7-27-77

MISSISSIPPI  
BOARD OF WATER COMMISSIONERS  
416 North State Street  
Jackson, Mississippi 39201

WATER WELL DRILLERS LOG

July 27 1977 Covington Pike  
date well completed firm name county well located

LANDOWNER: Clarence Speed

OSYKA miss

(mailing address)

WELL LOCATION:

sec. 15 T-1 N R-7 E  
2 miles north of OSYKA  
(distance) (direction) (nearest town)

WELL PURPOSE: Home  
(home, irrigation, municipal, industrial)

WELL COMPLETION DATA:

- (1) diameter (inches) 4
- (2) total depth (feet) 97
- (3) static water level (feet) 90 below above top of ground.
- (4) casing Plastic 87  
(material) (depth)
- 4 if telescope see back.  
(size)
- (5) screen 10 87  
(length) (depth to top)
- 4 Plastic  
(size) (material)
- (6) pump 1/2 8  
(HP) (yield gpm)
- (type power)
- (7) electric log \_\_\_\_\_  
(yes or no)
- (organization running log)
- (8) how well bottom plugged wood

description of formations encountered

| from | to |
|------|----|
| 0    | 17 |
| 17   | 35 |
| 35   | 57 |
| 57   | 90 |
| 90   | 97 |

CLAY  
CLAY GRAVEL  
SANDY CLAY  
CLAY  
SAND


RECEIVED  
AUG 5 1977

DRILLERS REMARKS:

MISS. BD. OF WATER COMMISSIONERS

If well telescopes please sketch and show depths.

GROUND LEVEL

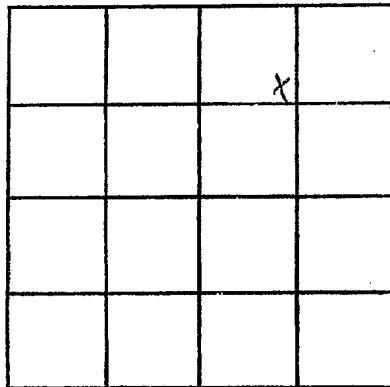

SECTION 15

Please indicate well location X.

ADDITIONAL INFORMATION

If more than one screen, show locations of each on sketch.