

Pike
 K 2014
 4/13/77

MISSISSIPPI
 BOARD OF WATER COMMISSIONERS
 416 North State Street
 Jackson, Mississippi 39201

30

WATER WELL DRILLERS LOG

April 13 1977 Meersville Inc. Pike
 date well completed firm name county well located

LANDOWNER:
Mr. E.R. Jacobson
Rt. Asyba
 (mailing address)

description of formations encountered	from	to
Clay & gravel	0	30
Sand	30	30
White Chalk	50	120
Reddish sand	120	140
Orange sand	140	162

WELL LOCATION:
 sec. 20 T-1 N R-7 E
3 miles N-NW of Asyba
 (distance) (direction) (nearest town)

WELL PURPOSE: home
 (home, irrigation, municipal, industrial)

WELL COMPLETION DATA:
 (1) diameter (inches) 4"
 (2) total depth (feet) 162
 (3) static water level (feet) 60 below above top of ground.
 (4) casing Plastic bottom (material) (depth)
 (size) if telescope see back.
 (5) screen 6" (length) 156 (depth to top)
4" (size) plastic (material)
 (6) pump 1/2 (HP) 10 (yield gpm)
elect (type power)
 (7) electric log no (yes or no)
 (organization, running log)


(8) how well bottom plugged
Wooden plug
 DRILLERS REMARKS:
old well hit by lightning

RECEIVED
 AUG 4 1977

MISS. BD. OF WATER COMMISSIONERS

If well telescopes please sketch and show depths.

GROUND LEVEL

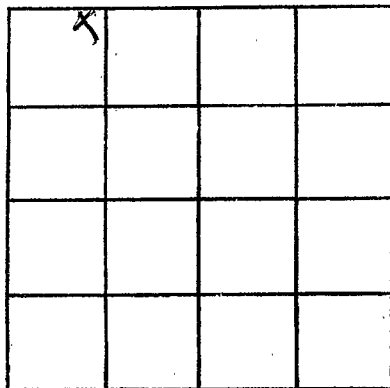

SECTION 20

Please indicate well location X.

ADDITIONAL INFORMATION

If more than one screen, show locations of each on sketch.