

Pike
K 2015
7-28-77

MISSISSIPPI
 BOARD OF WATER COMMISSIONERS
 416 North State Street
 Jackson, Mississippi 39201

144

WATER WELL DRILLERS LOG

7-28 date well completed 19 27 firm name Pike county well located

LANDOWNER:
Bill Bailey
R.R. Osypko
 (mailing address)

description of fomations encountered	from	to
<u>Red clay</u>	<u>0</u>	<u>20</u>
<u>Red sand</u>	<u>20</u>	<u>90</u>
<u>Coarse sand & gravel</u>	<u>90</u>	<u>100</u>

WELL LOCATION:
 sec. 13 T. 1 (N) S R. 7 (E) W
2 miles N of Osypko
 (distance) (direction) (nearest town)

WELL PURPOSE:
Home
 (home, irrigation, municipal, industrial)

- WELL COMPLETION DATA:
- (1) diameter (inches) 4
 - (2) total depth (feet) 100
 - (3) static water level (feet) 50 below above top of ground.
 - (4) casing PVC, 92,
 (material) (depth)
4 if telescope see back.
 (size)
 - (5) screen 8, 92
 (length) (depth to top)
4, PVC
 (size) (material)
 - (6) pump 3/4, 15
 (HP) (yield gpm)
3/4
 (type power)
 - (7) electric log no
 (yes or no)
 (organization running log)
 - (8) how well bottom plugged solid


DRILLERS REMARKS:

RECEIVED
 AUG 29 1977

MISS. BD. OF WATER COMM.

If well telescopes please sketch and show depths.

GROUND LEVEL

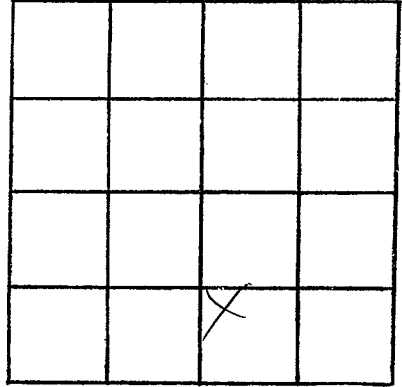

SECTION 13

Please indicate well location X.

ADDITIONAL INFORMATION

If more than one screen, show locations of each on sketch.