

PIKE

K. 207

4-11-18

MISSISSIPPI
 BOARD OF WATER COMMISSIONERS
 416 North State Street
 Jackson, Mississippi 39201

WATER WELL DRILLERS LOG

4-11 1978
date well completed

Fitzgibbon Well Serv
firm name

Pike
county well located


LANDOWNER:	description of formations encountered	from	to
Fred Miller			
R.R. Chetawa m/s (mailing address)	Red clay Red sand Coarse sand & gravel	0 20 90	20 90 116
WELL LOCATION:			
sec. 10 T. 1 N. R. 7 E. S W 2 1/2 miles W of Chetawa (distance) (direction) (nearest town)			
WELL PURPOSE: <u>hw</u> (home, irrigation, municipal, industrial)			
WELL COMPLETION DATA:			
(1) diameter (inches) <u>4</u>			
(2) total depth (feet) <u>116</u>			
(3) static water level (feet) <u>70</u> below above top of ground.			
(4) casing <u>PVC 108</u> , (material) (depth) <u>4</u> if telescope see back. (size)			
(5) screen <u>8 108</u> (length) (depth to top)			
(6) pump <u>4 15</u> (size) (material) <u>3/4 15</u> (HP) (yield gpm)			
(7) electric log <u>no</u> (yes or no) <u>el</u> (type power)			
(8) how well bottom plugged <u>level that</u> (organization running log)			
DRILLERS REMARKS:			

RECEIVED
 APR 27 1978

MISS. SD. OF WATER COMMISSIONERS

If well telescopes please sketch and show depths.

GROUND LEVEL

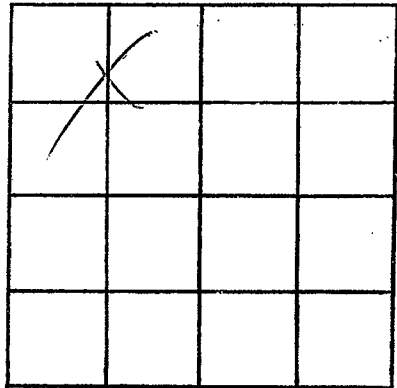

SECTION 10

Please indicate well location X.

ADDITIONAL INFORMATION

If more than one screen,
show locations of each on sketch.