

PIKE
K 2020
5-19-78

MISSISSIPPI  
BOARD OF WATER COMMISSIONERS  
416 North State Street  
Jackson, Mississippi 39201

WATER WELL DRILLERS LOG

May 19 1978 Beaver Well Co. Pike  
date well completed firm name county well located

LANDOWNER:

Motor Vehicle Comptroller  
PO Box 1140 Jackson  
South (mailing address)

WELL LOCATION:

sec 28 T 1 N R 7 E  
1 1/2 miles N-NW of Osyka  
(distance) (direction) (nearest town)

WELL PURPOSE: Industrial  
(home, irrigation, municipal, industrial)

WELL COMPLETION DATA:

- (1) diameter (inches) 4"
- (2) total depth (feet) 140
- (3) static water level (feet) 90 below top of ground.
- (4) casing plastic bottom (material) (depth)
- ✓ (size) if telescope see back.
- (5) screen 10' 180 (length) (depth to top)
- 4" plastic (size) (material)
- (6) pump 1 1/2 18 (HP) (yield gpm)
- elect (type power)
- (7) electric log no (yes or no)


(organization running log)

(8) how well bottom plugged Washer plug

DRILLERS REMARKS:

none


description of formations encountered	from	to
<u>Red Clay</u>	<u>0</u>	<u>24</u>
<u>Red sand</u>	<u>24</u>	<u>90</u>
<u>Gravel &amp; sand</u>	<u>90</u>	<u>112</u>
<u>pink chert &amp; sand</u>	<u>112</u>	<u>126</u>
<u>Red gravel &amp; sand</u>	<u>126</u>	<u>140</u>

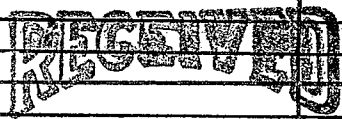

AUG 28 1978

If well telescopes please sketch and show depths.

GROUND LEVEL

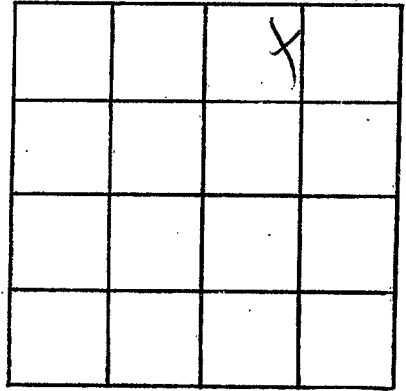

SECTION 28

Please indicate well location X.

ADDITIONAL INFORMATION

If more than one screen,  
show locations of each on sketch.