

PIKE
K 2022
9-1-78

**MISSISSIPPI  
BOARD OF WATER COMMISSIONERS**  
416 North State Street  
Jackson, Mississippi 39201

**WATER WELL DRILLERS LOG**

9-1-78 date well completed      F. Gouldwell Dr. Pike firm name      county well located

**LANDOWNER:**  
Percy McKinney  
P.R. Chataway  
(mailing address)

**WELL LOCATION:**  
sec. 11 T. 1 N. R. 7 E  
S. W.  
1 miles N of Chelena  
(distance) (direction) (nearest town)

**WELL PURPOSE:** Home  
(home, irrigation, municipal, industrial)

**WELL COMPLETION DATA:**

(1) diameter (inches) 4

(2) total depth (feet) 143

(3) static water level (feet) 35 below top of ground.

(4) casing PVC 135  
(material) (depth)  
4 if telescope see back.  
(size)

(5) screen 8 135  
(length) (depth to top)  
4 PVC  
(size) (material)


(6) pump 1/2 10  
(HP) (yield gpm)  
Electric  
(type power)

(7) electric log yes  
(yes or no)

(8) how well bottom plugged Sand plug

description of formations encountered	from	to
Red clay	0	20
Red sand	20	80
Red gravel	80	118
white chalk	118	130
Coarse sand & gravel	130	143

**DRILLERS REMARKS:**

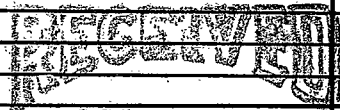


OCT 1 1978

MISS. BD. OF WATER COM. INT

If well telescopes please sketch and show depths.

GROUND LEVEL

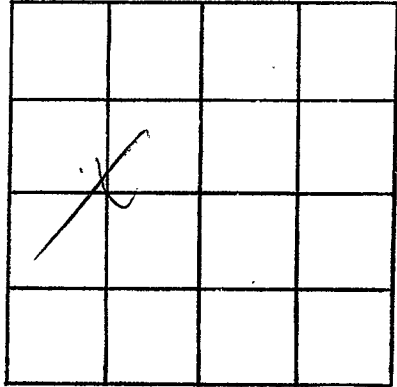

SECTION 11

Please indicate well location X.

ADDITIONAL INFORMATION

If more than one screen, show locations of each on sketch.