

PIKE
K 2024
5-1-79

MISSISSIPPI
BOARD OF WATER COMMISSIONERS
416 North State Street
Jackson, Mississippi 39201

WATER WELL DRILLERS LOG

Pike
County

5-1-79
date well completed

F. J. Hamilton
firm name

county well located

LANDOWNER:
F. J. Hamilton
R. B. Osyke
(mailing address)

description of formations encountered	from	to
Red Clay	0	20
Red Soil	20	60
Fine Sand	60	120
Coarse sand & gravel	120	136

WELL LOCATION:
sec. 32 T-1 N R-7 E
S W
5 miles west of Osyke
(distance) (direction) (nearest town)

WELL PURPOSE: Home
(home, irrigation, municipal, industrial)

WELL COMPLETION DATA:
(1) diameter (inches) 4
(2) total depth (feet) 136
(3) static water level (feet) 50 below top of ground.
(4) casing PVC 128 (material) (depth)
1/2" if telescope see back. (size)
(5) screen 8 128 (length) (depth to top)
1/2" PVC (size) (material)
(6) pump 1/2 10 (HP) (yield gpm)
alo (type power)
(7) electric log BY (yes or no)
(organization running log)
(8) how well bottom plugged Seal

DRILLERS REMARKS:


Miss. Board of Water Comm.

MAY 30 1979

RECEIVED

If well telescopes please sketch and show depths.

GROUND LEVEL

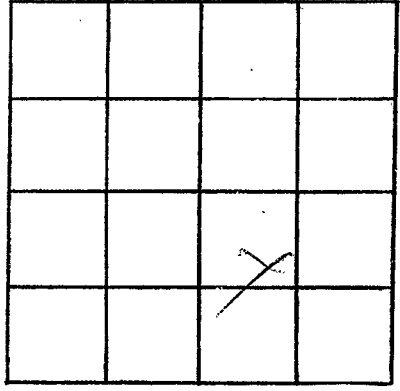

SECTION 30

Please indicate well location X.

ADDITIONAL INFORMATION

A series of horizontal lines for writing additional information, starting below the 'ADDITIONAL INFORMATION' header and extending to the bottom of the page.

If more than one screen, show locations of each on sketch.