

PIKE  
K 2026  
5-3-79

MISSISSIPPI  
BOARD OF WATER COMMISSIONERS  
416 North State Street  
Jackson, Mississippi 39201

WATER WELL DRILLERS LOG

5-3 1979 *Thompson Well Serv* *Pike*  
date well completed firm name county well located

LANDOWNER:  
*Carlton V. Hudson*  
*B.R. Osyke*  
(mailing address)

description of formations encountered	from	to
<i>Red Clay</i>	<i>0</i>	<i>20</i>
<i>Coarse sand &amp; gravel</i>	<i>20</i>	<i>95</i>
<i>Fine sand</i>	<i>95</i>	<i>120</i>
<i>Coarse sand &amp; gravel</i>	<i>120</i>	<i>136</i>

WELL LOCATION:  
sec. *21* T. *1* N. R. *7* E  
*1/4* miles *NW* of *Osyke*  
(distance) (direction) (nearest town)

WELL PURPOSE: *Home*  
(home, irrigation, municipal, industrial)

- WELL COMPLETION DATA:
- (1) diameter (inches) *4*
  - (2) total depth (feet) *136*
  - (3) static water level (feet) *77* above top of ground.
  - (4) casing *PVC*, *128*,  
(material) (depth)  
*4* if telescope see back.  
(size)
  - (5) screen *8*, *128*  
(length) (depth to top)  
*4*, *PVC*  
(size) (material)
  - (6) pump *1/2*, *10*  
(HP) (yield gpm)  
*ela*  
(type power)
  - (7) electric log *no*  
(yes or no)  
(organization running log)
  - (8) how well bottom plugged *Sealed*

DRILLERS REMARKS:


Miss. Board of Water Comm.

MAY 30 1979

RECEIVED

If well telescopes please sketch and show depths.

GROUND LEVEL

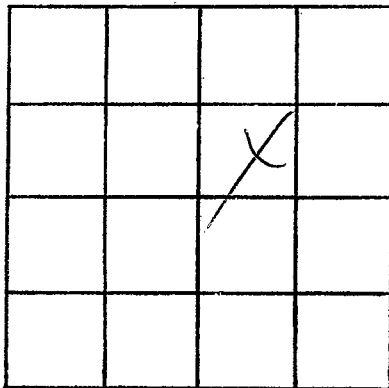

SECTION 21

Please indicate well location X.

ADDITIONAL INFORMATION

If more than one screen, show locations of each on sketch.