

Pike
 K 207A
 7-12-79

MISSISSIPPI
 BOARD OF WATER COMMISSIONERS
 416 North State Street
 Jackson, Mississippi 39201

WATER WELL DRILLERS LOG

July 12 1979 Reems well Co Pike
 date well completed firm name county well located

LANDOWNER:
 Jesse Harrell
 Rt. Magnolia
 (mailing address)

description of formations encountered	from	to
Clay	0	21
gravel & sand	21	55
lumpy sand	55	77
coarse sand	77	99

WELL LOCATION:
 sec. 14 T-1 N R-7 E
 5 1/2 miles South of Magnolia
 (distance) (direction) (nearest town)

WELL PURPOSE: home
 (home, irrigation, municipal, industrial)

WELL COMPLETION DATA:
 (1) diameter (inches) 4"
 (2) total depth (feet) 99
 (3) static water level (feet) 48 below top of ground.
 (4) casing plastic bottom (material) (depth)
 (size) if telescope see back.
 (5) screen 5' 94' (length) (depth to top)
 4" plastic (size) (material)
 (6) pump brother (HP) (yield gpm)
 elect (type power)
 (7) electric log no (yes or no)
 (organization running log)

(8) how well bottom plugged
 wooden plug
 DRILLERS REMARKS:


DEPT. OF NATURAL RESOURCES
 BUREAU OF LAND & WATER RESOURCES

MAR 5 - 1980

RECEIVED

If well telescopes please
sketch and show depths.

GROUND LEVEL

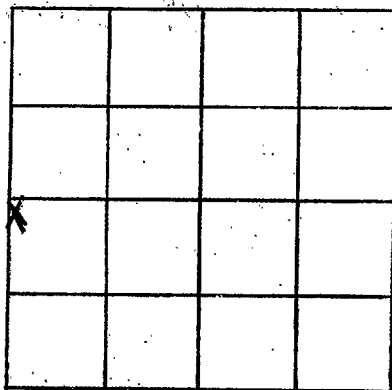

SECTION 14

Please indicate well location X.

ADDITIONAL INFORMATION

If more than one screen,
show locations of each on sketch.